

YAMH 024

>> 45/30/31 hd
18795

(START CARD) #

(1) OWNER: Well Number: 1129
Name JOHN STOLLER
Address _____
City _____ State _____ Zip _____

(2) TYPE OF WORK:
 New Well Deepen Recondition Abandon

(3) DRILL METHOD
 Rotary Air Rotary Mud Cable
 Other _____

(4) PROPOSED USE:
 Domestic Community Industrial Irrigation
 Thermal Injection Other _____

(5) BORE HOLE CONSTRUCTION: 159
Special Construction approval Yes No Depth of Completed Well _____ ft.
Yes No
Explosives used Type _____ Amount _____

HOLE			SEAL			Amount sacks or pounds
Diameter	From	To	Material	From	To	
16	0	20	CEMENT	0	20	27 SAX
12	20	159				

How was seal placed: Method A B C D E
 Other _____
Backfill placed from _____ ft. to _____ ft. Material _____
Gravel placed from 20 ft. to 159 ft. Size of gravel 3/8" P

(6) CASING/LINER:

Casing:	Diameter	From	To	Gauge	Steel	Plastic	Welded	Threaded
					<input checked="" type="checkbox"/>	<input type="checkbox"/>	<input checked="" type="checkbox"/>	<input type="checkbox"/>
	8	+2	159	.25	<input checked="" type="checkbox"/>	<input type="checkbox"/>	<input checked="" type="checkbox"/>	<input type="checkbox"/>
Liner:					<input type="checkbox"/>	<input type="checkbox"/>	<input type="checkbox"/>	<input type="checkbox"/>

Final location of shoe(s) _____

(7) PERFORATIONS/SCREENS:
 Perforations Method TORCH
 Screens Type _____ Material _____

From	To	Slot size	Number	Diameter	Tele/pipe size	Casing	Liner
115	155	6"	320			<input checked="" type="checkbox"/>	<input type="checkbox"/>

(8) WELL TESTS: Minimum testing time is 1 hour

Yield gal/min	Drawdown	Drill stem at	Time
400.00		150	1 hr.
400		150	11

Temperature of water _____ Depth Artesian Flow Found _____
Was a water analysis done? Yes By whom _____
Did any strata contain water not suitable for intended use? Too little
 Salty Muddy Odor Colored Other _____
Depth of strata: _____

(9) LOCATION OF WELL by legal description:
County YAMHILL Latitude _____ Longitude _____
Township 4 S N or S, Range 3 W E or W, WM.
Section 31 SE 1/4 NW 1/4
Tax Lot _____ Lot _____ Block _____ Subdivision _____
Street Address of Well (or nearest address)
11000 SE LAFAYETTE HWY DAYTON,

(10) STATIC WATER LEVEL:
20 ft. below land surface. Date 05/03/90
Artesian pressure _____ lb. per square inch. Date _____

(11) WATER BEARING ZONES:
Depth at which water was first found 105

From	To	Estimated Flow Rate	SWL
105	150	400	20

(12) WELL LOG: Ground elevation _____

Material	From	To	SWL
TOP SOIL	0	2	
BROWN SILTY CLAY	2	15	
BLUE CLAY	15	65	
STICKY BROWN CLAY	65	75	
BLUE CLAY W/FINE BLK SAND	75	100	
BLUE CLAY W/SAND & GRAVEL	100	150	20
STICKY BLUE CLAY	150	159	
BLUE WATER DRILLING CO.			
DAYTON, OR	97114		

Date started 04/25/90 Completed 05/03/90

(unbonded) Water Well Constructor Certification:
I certify that the work I performed on the construction, alteration, or abandonment of this well is in compliance with Oregon well construction standards. Materials used and information reported above are true to my best knowledge and belief.
Signed *Harry R. Trent* WWC Number 1516
Date 05/03/90

(bonded) Water Well Constructor Certification:
I accept responsibility for the construction, alteration, or abandonment work performed on this well during the construction dates reported above. all work performed during this time is in compliance with Oregon well construction standards. This report is true to the best of my knowledge and belief.
Signed *Robert B. Helburn* WWC Number 417
Date 5-3-90

FOR WATER RESOURCES DEPARTMENT USE ONLY

Date Postmarked 4-25-90
Date Hand-delivered _____
Watermaster Initials _____

CR

W-18795
WRD Receipt 62848
Date Fee Received 4-26-90

OK # 10123

START CARD
NOTICE OF BEGINNING OF WELL CONSTRUCTION
(as required by ORS 537.762)

APR 26 1990

This form must be completed, signed by both the owner (or authorized agent) and constructor, and the original mailed or delivered to the Water Resources Department, 3850 Portland Road NE, Salem, OR 97310, no later than the day construction, alteration, conversion or abandonment work begins. A **\$75 fee shall accompany all notices for new well construction or conversion of an existing hole not previously used as a water well** (make checks payable to the Water Resources Department). Notices meeting this requirement but received without the required fee **will not be accepted** as properly and timely filed. The Water Resources Commission has authority to impose civil penalties for failure to submit the required \$75 fee with the start card and for failure to submit cards prior to beginning any construction, alteration, conversion or abandonment work.

Owner's name and mailing address JOHN STOLLER
15041 Stoller Rd NE
DAYTON, OR 97114


Check type of work: New construction Repair Recondition
 Deepening Conversion Abandonment

Proposed Commencement Date 4-25-90

Existing or Proposed Well Depth 150 Diameter 8

Check Use: Domestic Community Industrial Irrigation Monitoring
 Thermal Injection Other _____

Proposed Well Location: County YAMHILL
Township 4 (N or S) Range 3 (E or W) Section 31

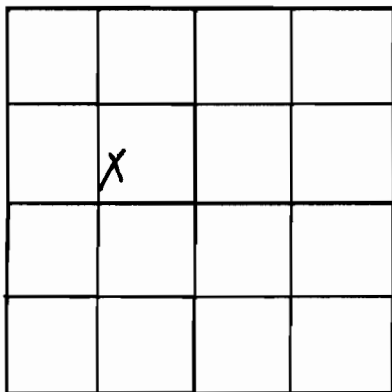

- SE 1/4 of NW 1/4 of above section
- Street address of 11000 SE Lafayette Hwy
well location DAYTON
- Tax lot number of well location _____
- Attach map with location identified.
(See reverse of this form for approved maps)
- Show well location within 1/4, 1/4 of section grid at left.

We hereby certify that we have read the back of this form, and that to the best of our knowledge the information provided herein is accurate and the well is being properly located from septic tanks and septic drain fields.

[Signature]
Owner's signature

Robert D. Halburne
Bonded Water Well Constructor

PREA
Title 4-24-90
Date

License No. 417

864-2325
Home phone
Work phone

Company Blue Water Drilling Co.

NOTE: This is not a water right application. The owner is responsible for obtaining a water right through the Water Resources Department, if required.

THIS COPY TO WATER RESOURCES DEPARTMENT IN SALEM
If no fee applies, discard this copy

YAMH 24

For Official Use Only:

Received Date:

County Well Log ID No.

Well Identification Tag No.

01/06/98

YAMH 24

L 21407

WELL IDENTIFICATION APPLICATION FORM

BUYER/CURRENT WELL OWNER:

Name: CURT JOHNSTON

Mailing Address: 11320 SE LAFAYETTE HIGHWAY

City: DAYTON State: OR Zip: 97114 Phone: _____

WELL LOCATION:

County: YAMHILL Owner's Well Number: C

Township: 4 N or S SOUTH Range: 3 E or W WEST Section: 31 NW 1/4 SW 1/4

Tax Lot #: 1100 Type of Well: water supply monitoring _____

BERNE

Street Address of Well (if different from above): 11320 SE LAFAYETTE HIGHWAY

DAYTON, OR 97114

WELL INFORMATION: (do not complete remainder of application if well log is available)

Start Card Number: _____ Approx. Construction Date: _____

Well Constructor: _____

Name of Owner at Time of Construction: _____

Well Depth (in feet): _____ Static Water Level (in feet): _____

Diameter of Exposed Well Casing (in inches): _____

Does this well have a formal water right associated with it? Yes: _____ No: _____

If Yes: Application #: _____ Permit #: _____ Certificate #: _____

Please Return Completed Form to:

**Lisa Juul
Well Identification Program
Oregon Water Resources Department
158 12th Street NE
Salem, OR 97310**