

STATE ENGINEER
Salem, Oregon

Yamh
2410 OBSERVATION WELL
Well Record

STATE WELL NO. 3/2W-17A(1)
COUNTY Yamhill
APPLICATION NO. GR-503

ADEC. Corp.

OWNER: Mack & Thea Bennett


MAILING ADDRESS: Rt. 2,

LOCATION OF WELL: Owner's No. _____

CITY AND STATE: Newberg, Oregon

NE 1/4 NE 1/4 Sec. 17 T. 3 S., R. 2 W., W.M.

Bearing and distance from section or subdivision corner 1070' SW of NE cor. Sec. 17

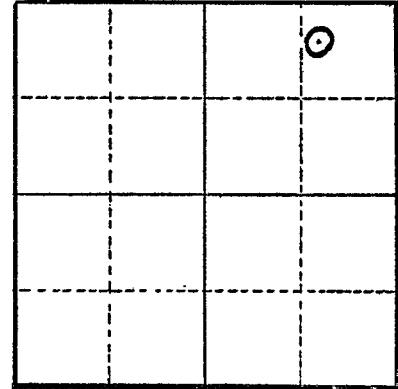

Section 17

Altitude at well 240'

TYPE OF WELL: Drilled Date Constructed Nov. '50

Depth drilled 200 1/2 Depth cased 194 1/2

CASING RECORD:

12 inch

FINISH:

AQUIFERS:

WATER LEVEL:

45

PUMPING EQUIPMENT: Type Fairbanks Morse "Little Chief" H.P. 5
Capacity _____ G.P.M.

WELL TESTS:

Drawdown 180 ft. after _____ hours 23 G.P.M.

Drawdown _____ ft. after _____ hours _____ G.P.M.

USE OF WATER Irrigation Temp. _____ °F., 19 _____

SOURCE OF INFORMATION GR-503

DRILLER or DIGGER John Meeker

ADDITIONAL DATA:

Log Water Level Measurements _____ Chemical Analysis _____ Aquifer Test _____

REMARKS:

