

Material	From	To
Clay, brown silty	0	27
Gravel, small pea size + coarse sand	27	35
Gravel, pea + coarse sand up to 3"	35	53
Gravel, pea size up to 2"	53	60
Clay, green w/ gravel	60	63
Clay, gray	63	77
Clay, gray & brown mixed	77	84
Clay, gray	84	88
Clay, gray & brown mixed	88	114
Clay, gray & powdery white	114	115
Clay, green & brown mixed	115	117
Clay, gray	117	119
Clay, gray & brown mixed	119	135
Clay, gray soft & gritty	135	136
Clay, gray	136	137
Clay, black	137	139
Clay, gray	139	156
Clay, gray & brown mixed	156	167
Clay, gray	167	188
Clay, gray & brown mixed somewhat gritty	188	196
Clay, brown silty somewhat silty	196	201
Clay, gray soft sticky	201	206
Clay, gray & brown mixed	206	217
Clay, blue & brown mixed soft, silty & somewhat gritty	217	220
Clay, black	220	226
Clay, gray	226	240
Clay, brown gritty	240	253
Clay, gray	253	266
Clay, brown silty w/ some fine sand	266	268
Gravel, fine & sand, fine, brown	268	271
Clay, brown soft	271	284
Clay, brown silty soft - somewhat gritty	284	288
Clay, brown	288	313

RECEIVED

AUG 8 1978

WATER RESOURCES DEPT.
SALEM, OREGON


36

38' static 5/2/78 @ 7:45am

City of Dundee Well Tests

Pumping Level (PL), (feet below ground level)

NOTE: Tests were run on two consecutive days in order to obtain more sustained yield & recovery data.

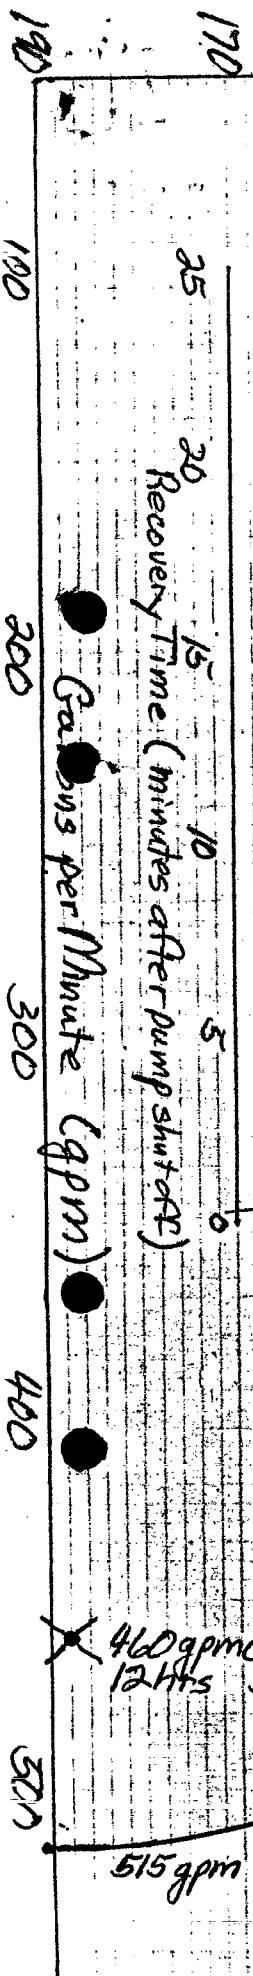

SCHNEIDER EQUIPMENT, INC.
 21881 RIVER ROAD N. E.
 ST. PAUL, OREGON 97137
 (503) 633-2666

RECEIVED

AUG 7 1978
 WATER RESOURCES DEPT.
 SALEM, OREGON