

WELL RECORD

STATE ENGINEER
Salem, Oregon

Well Record

STATE WELL NO. 5/4W-25G(1)
COUNTY Yamhill
APPLICATION NO. GR-991

YAMHILL
7099
3900

GR- 960

OWNER: Peter Parvin


MAILING ADDRESS: Rt. 1, Box 216

LOCATION OF WELL: Owner's No.

CITY AND STATE: Amity, Oregon

SW 1/4 NE 1/4 Sec. 25 T. 5 S., R. 4 W., W.M.

Bearing and distance from section or subdivision corner 1920' S. & 500' E. from N.E. cor. Sec. 25.

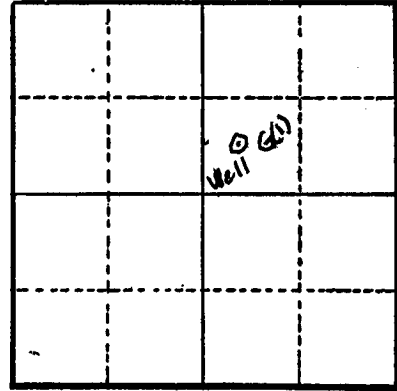

Section 25

Altitude at well 450 ft.

TYPE OF WELL: Drilled Date Constructed 1954

Depth drilled 268 ft. Depth cased 50 ft.

CASING RECORD:

10 INCH - 6 INCH ?

FINISH:

AQUIFERS:

WATER LEVEL:

225 ft.

PUMPING EQUIPMENT: Type Submerged Turbine H.P. 15

Capacity 100 G.P.M.

WELL TESTS:

Drawdown 30 ft. after 75 hours G.P.M.

Drawdown ft. after hours G.P.M.

USE OF WATER Irrigation Temp. °F. 19

SOURCE OF INFORMATION G.R. Record

DRILLER or DIGGER Miller

ADDITIONAL DATA:

Log Water Level Measurements Chemical Analysis Aquifer Test

REMARKS:

Log: Soil 0 to 5 ft.
Clay & shale 5 to 50 ft.
Solid rock 50 to 268 ft.

Irrigation of 10.5 acres.