

STATE ENGINEER
Salem, Oregon

YAMH
4119

Well Record

STATE WELL NO. 3/3W-11P
COUNTY Yamhill
APPLICATION NO. GR3009

OWNER: Theodore B. and Lenore J. Stone


MAILING ADDRESS: Route 3, Box 94-A

LOCATION OF WELL: Owner's No. _____

CITY AND STATE: Newberg, Oregon

SE 1/4 SW 1/4 Sec. 11 T. 3 N. S., R. 3 E. W., W.M.

Bearing and distance from section or subdivision corner 780' N. and 1900' E. from SW Corn. Sec. 11

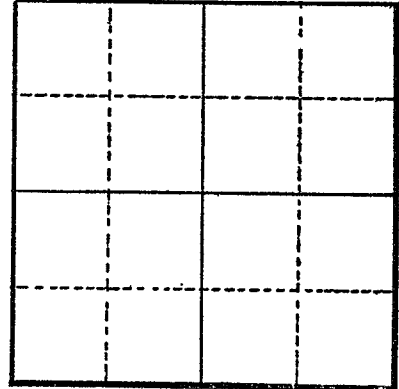

Section _____

Altitude at well _____

TYPE OF WELL: drilled Date Constructed 1950

Depth drilled 69 Depth cased 69

CASING RECORD:

6 inch

FINISH:

perforated 1/4 inch by 1 foot, torch perforations, from bottom up to 12 feet

AQUIFERS:

Shale, and black sand

WATER LEVEL:

16 feet

PUMPING EQUIPMENT: Type Fairbanks Morse - Jet type H.P. 1
Capacity 25 G.P.M.

WELL TESTS:

Drawdown 4 ft. after _____ hours pumping 25 G.P.M.

Drawdown _____ ft. after _____ hours _____ G.P.M.

USE OF WATER Irrigation Temp. _____ °F. _____, 19_____

SOURCE OF INFORMATION GR-2818

DRILLER or DIGGER Wilcox Drilling, McMinnville, Oregon

ADDITIONAL DATA:

Log Water Level Measurements _____ Chemical Analysis _____ Aquifer Test _____

REMARKS:

Shale and black sand, water was found in fractured shale and black sand.