

STATE ENGINEER
Salem, Oregon

YAMH Well Record
4585

STATE WELL NO. 3/3W - 29N
COUNTY YAMHILL
APPLICATION NO. GR-2175

OWNER: Trappist Abbey of Our Lady of
Guadalupe


MAILING ADDRESS: Lafayette,

LOCATION OF WELL: Owner's No. #4

CITY AND STATE: Oregon

NE 1/4 SW 1/4 SW 1/4 Sec. 29 T. 3 N. S., R. 3 E. W., W.M.

Bearing and distance from section or subdivision
corner 1269' N. and 989' E.

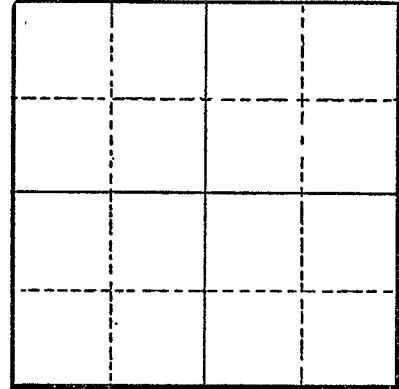

Section

Altitude at well

TYPE OF WELL: Drilled Date Constructed

Depth drilled 108 Depth cased

CASING RECORD:

6-Inch

FINISH:

AQUIFERS:

WATER LEVEL:

14-Feet

PUMPING EQUIPMENT: Type Pacific Jet

H.P. 2

Capacity 3 G.P.M.

WELL TESTS:

Drawdown 90 ft. after hours Pumping 28 G.P.M.

Drawdown ft. after hours G.P.M.

USE OF WATER Irrigation & Domestic Temp. °F. 19

SOURCE OF INFORMATION GR-2084

DRILLER or DIGGER

ADDITIONAL DATA:

Log Water Level Measurements Chemical Analysis Aquifer Test

REMARKS: