

STATE ENGINEER
Salem, Oregon

YAMH

4934

Well Record

STATE WELL NO. 3/4W-29E
COUNTY Yamhill
APPLICATION NO. GR-1883

OWNER: Wm. H. Lambright

MAILING

ADDRESS:

Route 1, Box 176

LOCATION OF WELL: Owner's No.

CITY AND

STATE:


Carlton, Oregon

SW 1/4 NW 1/4 Sec. 29 T. 3 N. 4 E. S. R. W., W.M.

Bearing and distance from section or subdivision

corner 280 feet East and 250 feet North from the

W1/4 Corner, Section 29.

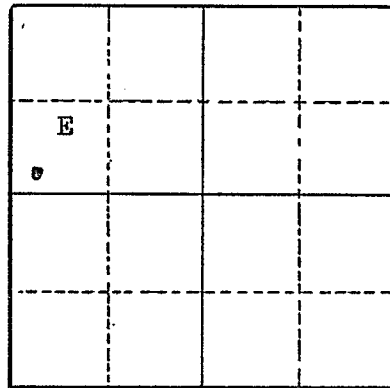

Section 29

Altitude at well 200 feet

TYPE OF WELL: Drilled Date Constructed Oct. 10, '51

Depth drilled 116 feet Depth cased 80 feet

CASING RECORD:

8-inch casing set from 35 to 40 feet

FINISH:

AQUIFERS:

dirt and solid rock

WATER LEVEL:

40 feet

PUMPING EQUIPMENT: Type Berkeley 602

H.P.

Capacity 105 G.P.M.

WELL TESTS:

Drawdown 114 ft. after 70 hours G.P.M.

Drawdown ft. after hours G.P.M.

USE OF WATER Irrigation Temp. °F. 19

SOURCE OF INFORMATION GR-4090

DRILLER or DIGGER Wilcox, McMinnville

ADDITIONAL DATA:

Log X Water Level Measurements Chemical Analysis Aquifer Test

REMARKS:

Thickness

Dirt about 38

solid rock 78