

STATE ENGINEER
Salem, Oregon

YAMH
4956

Well Record


STATE WELL NO. 3/4W-34P(1)
COUNTY Yamhill
APPLICATION NO. GR-458

OWNER: Arnold Widness
MAILING ADDRESS: P. O. Box 573

LOCATION OF WELL: Owner's No. _____
CITY AND STATE: _____

SE 1/4 SW 1/4 Sec. 34 T. 3 S., R. 4 W., W.M.

Bearing and distance from section or subdivision
corner 24.03 chains W. 36.73 chains N. and S. 42°
E. 240' from SE cor. A. T. Hombree DLC

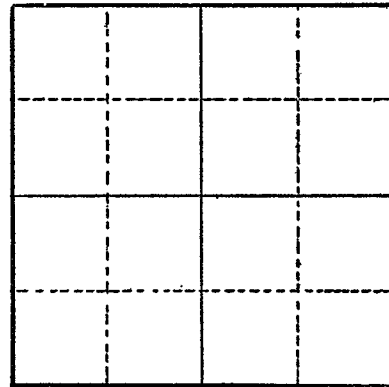

Section 34

Altitude at well 150

TYPE OF WELL: Drilled Date Constructed Sept. 51

Depth drilled 95 Depth cased 95

CASING RECORD:

6 inch

FINISH:

AQUIFERS:

WATER LEVEL:

20 feet

PUMPING EQUIPMENT: Type Fairbanks Morse Turbine H.P. 3
Capacity 33 G.P.M.

WELL TESTS:

Drawdown _____ ft. after _____ hours _____ G.P.M.
Drawdown _____ ft. after _____ hours _____ G.P.M.

USE OF WATER Irrigation 6 acres Temp. _____ °F., 19

SOURCE OF INFORMATION GR-458

DRILLER or DIGGER Wilcox

ADDITIONAL DATA:

Log _____ Water Level Measurements _____ Chemical Analysis _____ Aquifer Test _____

REMARKS:

Dirt 0 to 75 feet
Gravel 75 to 95 feet