

STATE ENGINEER
Salem, Oregon

OBSERVATION WELL
Well Record

STATE WELL NO. 4/11-6N ³ ccb
COUNTY Yamhill
APPLICATION NO. GR-1492

YAMH
5228

GR- 1442

OWNER: Alice G. Flanigan, Recorder for the
Town of Lafayette


MAILING ADDRESS: P. O. Box 136

LOCATION OF WELL: Owner's No. #1

CITY AND STATE: Lafayette, Oregon

SW 1/4 SW 1/4 Sec. 6 T. 4 ^N S., R. 4 ^E W., W.M.

Bearing and distance from section or subdivision
corner 850' N. & 650' E. from SW cor. Sec. 6

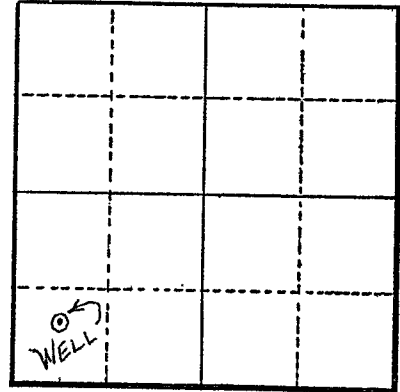

Section 6

Altitude at well _____

TYPE OF WELL: Drilled Date Constructed 1915

Depth drilled 240' Depth cased 240'

CASING RECORD:

10"

FINISH:

AQUIFERS:

WATER LEVEL:

70'

PUMPING EQUIPMENT: Type Turbine H.P. 25
Capacity 330 G.P.M.

WELL TESTS:

Drawdown 40 ft. after _____ hours 330 G.P.M.

Drawdown _____ ft. after _____ hours _____ G.P.M.

USE OF WATER Municipal Temp. _____ °F. _____, 19____

SOURCE OF INFORMATION GR Record

DRILLER or DIGGER _____

ADDITIONAL DATA:

Log N.A. Water Level Measurements _____ Chemical Analysis _____ Aquifer Test _____

REMARKS:

~~XXXXXXXXXXXX~~