

STATE ENGINEER
Salem, Oregon

YAMHILL Well Record

STATE WELL NO. 4/3W-7K
COUNTY Yamhill
APPLICATION NO. GR-4263

5242

OWNER: Charles and Mable Dooley


MAILING ADDRESS: Route 2, Box 273

LOCATION OF WELL: Owner's No. _____

CITY AND STATE: Dayton, Oregon

NW 1/4 SE 1/4 Sec. 7 T. 4 N. S., R. 3 W., W.M.

Bearing and distance from section or subdivision
corner 1300 feet East and 50 feet South from
center of Section 7.

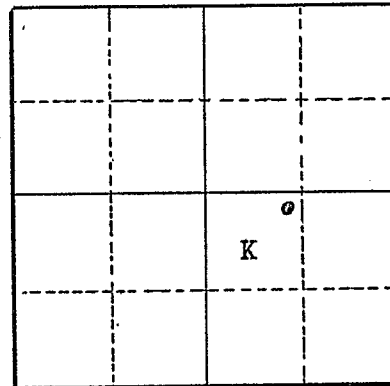

Section 7

Altitude at well _____

TYPE OF WELL: Drilled Date Constructed 7-19-55

Depth drilled 84 feet Depth cased 84 feet

CASING RECORD:

6 5/8 inch casing set from top to 84 feet

FINISH:

35 1/8" by 16' from 50' to 84'

AQUIFERS:

sand and clay

WATER LEVEL:

20 feet

PUMPING EQUIPMENT: Type Reda Submersible 1In. H.P. _____

Capacity _____ G.P.M.

WELL TESTS:

Drawdown 60 ft. after _____ hours 18 G.P.M.

Drawdown _____ ft. after _____ hours _____ G.P.M.

USE OF WATER Irrigation Temp. _____ °F. _____, 19 _____

SOURCE OF INFORMATION GR-4114

DRILLER or DIGGER _____

ADDITIONAL DATA:

Log Water Level Measurements _____ Chemical Analysis _____ Aquifer Test _____

REMARKS:

top soil	0	3
yellow clay	3	12
blue clay	12	38
black sand	38	42
blue clay	42	65
black sand	65	77
blue clay	77	84