

STATE ENGINEER
Salem, Oregon

YAMHILL Well Record

5358


STATE WELL NO. 4/3W-18R
COUNTY Yamhill
APPLICATION NO. GR-3289

OWNER: Lanada ^{G.} ~~F.~~ McFee MAILING ADDRESS:

LOCATION OF WELL: Owner's No. CITY AND STATE: Dayton, Oregon

SE 1/4 SE 1/4 Sec. 18 T. 4 S., R. 3 W., W.M.

Bearing and distance from section or subdivision corner 680 feet North and 490 feet West from the SE Corner, Section 9.

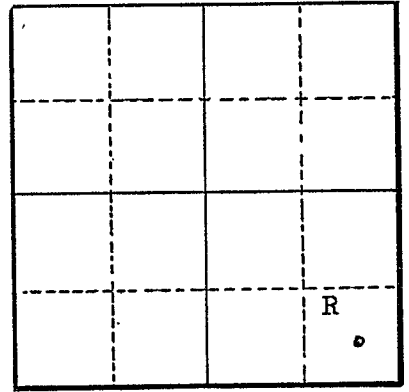

Altitude at well 100 feet

TYPE OF WELL: Drilled Date Constructed July 4, 1955

Depth drilled 73 feet Depth cased 69 feet

Section 18

CASING RECORD:

6-inch casing set from 6 to 69 feet

FINISH:

24' -3/16" holes

AQUIFERS:

WATER LEVEL:

25 feet

PUMPING EQUIPMENT: Type 1/2 hp. Demming Jet Pump H.P.

Capacity 30 G.P.M.

WELL TESTS:

Drawdown 15 ft. after 100 hours G.P.M.
Drawdown ft. after hours G.P.M.

USE OF WATER Irrigation Temp. °F., 19

SOURCE OF INFORMATION GR-4081

DRILLER or DIGGER Lanada McFee

ADDITIONAL DATA:

Log (NA) Water Level Measurements Chemical Analysis Aquifer Test

REMARKS: