

STATE ENGINEER  
Salem, Oregon

**YAMHILL Well Record**  
5366

STATE WELL NO. 4/3W-18 & 19  
COUNTY YAMHILL  
~~APPLICATION NO.~~ GR-2316

OWNER: Dean M. Cockerham

MAILING ADDRESS: Rt. 2, Box 151


LOCATION OF WELL: Owner's No.

CITY AND STATE: Dayton, Oregon

1/4 1/4 Sec. 18-19 T. 4 N. S., R. 3 W., W.M.

Bearing and distance from section or subdivision corner 460' West of Lafayette Hopewell Road on

Dividing Line

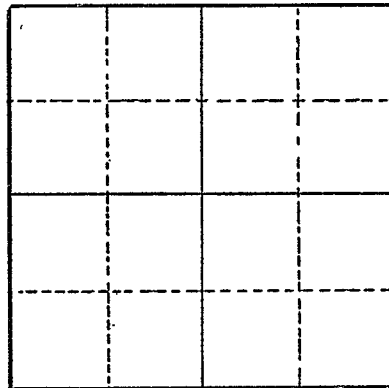

Section

Altitude at well

TYPE OF WELL: Drilled Date Constructed 1951

Depth drilled 96 Depth cased 96

CASING RECORD:

8-inch

FINISH:

AQUIFERS:

WATER LEVEL:

14-feet

PUMPING EQUIPMENT: Type Advance Jet-Type H.P. 5  
Capacity 90 G.P.M.

WELL TESTS:

Drawdown 65 ft. after hours Pumping 230 G.P.M.  
Drawdown ft. after hours G.P.M.

USE OF WATER Irrigation Temp. °F., 19

SOURCE OF INFORMATION GR-2206  
DRILLER or DIGGER John Wilcox, McMinnville, Oregon

ADDITIONAL DATA:

Log Water Level Measurements Chemical Analysis Aquifer Test

REMARKS: