

STATE ENGINEER
Salem, Oregon


YAMHILL Well Record
5380

STATE WELL NO. *4/3W-20C*
COUNTY *Yamhill*
APPLICATION NO. *GR-1794*

OWNER: *Milton A. Palmer* MAILING ADDRESS:

LOCATION OF WELL: Owner's No. CITY AND STATE: *Dayton, Oregon*

NE 1/4 *NW* 1/4 Sec. *20* T. *4* S., R. *3* W., W.M.
Bearing and distance from section or subdivision
corner *150 feet South and 1875 feet East*
of the Northwest corner of NE 1/4 NW 1/4, Section 20,
T. 4 S., R. 3 W., W.M.

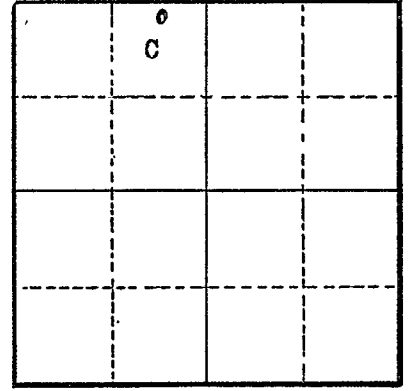

Section *20*

Altitude at well

TYPE OF WELL: *Drilled* Date Constructed *1948*

Depth drilled *118 feet* Depth cased *118 feet*

CASING RECORD:

6-inch casing (steel) from surface to 118 feet

FINISH:

AQUIFERS:

WATER LEVEL:

60 feet

PUMPING EQUIPMENT: Type *Deming* H.P.
Capacity *11* G.P.M.

WELL TESTS:

Drawdown ft. after hours G.P.M.
Drawdown ft. after hours G.P.M.

USE OF WATER *Irrigation* Temp. °F., 19....

SOURCE OF INFORMATION *GR-4097*

DRILLER or DIGGER *Fred Wymore, Salem, Oregon*

ADDITIONAL DATA:

Log *(NA)* Water Level Measurements Chemical Analysis Aquifer Test

REMARKS: