

STATE ENGINEER
Salem, Oregon

YAMHILL
5381 **Well Record**


STATE WELL NO. 4/3W-20C
COUNTY YAMHILL
APPLICATION NO. GR-4093

OWNER: Lucien Buzit MAILING ADDRESS: Rt 1 Box 7A

LOCATION OF WELL: Owner's No. CITY AND STATE: Dayton, Oregon

NE 1/4 NW 1/4 Sec. 20 T. 4 S., R. 3 W., W.M.

Bearing and distance from section or subdivision corner 20'SW & 7' SE of the NE cor Sec 20

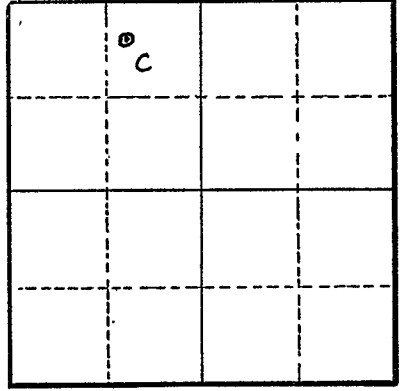

Section 20

Altitude at well _____

TYPE OF WELL: Drilled Date Constructed 1952

Depth drilled 85' Depth cased _____

CASING RECORD:

6-inch all way

FINISH: about 4' of 1/8 - 1/4" burned slottings

AQUIFERS:

WATER LEVEL: NA

PUMPING EQUIPMENT: Type Pacific Pumping H.P. 1
Capacity 13.33 G.P.M.

WELL TESTS:
Drawdown _____ ft. after _____ hours _____ G.P.M.
Drawdown _____ ft. after _____ hours _____ G.P.M.

USE OF WATER Irrigation Temp. _____ °F. _____, 19_____

SOURCE OF INFORMATION GR-3953
DRILLER or DIGGER Fred Wymore

ADDITIONAL DATA:
Log NA Water Level Measurements _____ Chemical Analysis _____ Aquifer Test _____

REMARKS: