

STATE ENGINEER
Salem, Oregon

YAMM Well Record
5382

STATE WELL NO. 4/3W-20D(1)
COUNTY Yamhill
APPLICATION NO. GR-244

OWNER: Earl Lofton & Lucy Lofton


MAILING ADDRESS: Route 1, Box 7 B

LOCATION OF WELL: Owner's No. #1

CITY AND STATE: Dayton, Oregon

NW 1/4 NW 1/4 Sec. 20 T. 4 N. S., R. 3 E. W., W.M.

Bearing and distance from section or subdivision corner 1200 feet east and 450 feet south from NW corner of Section 20.

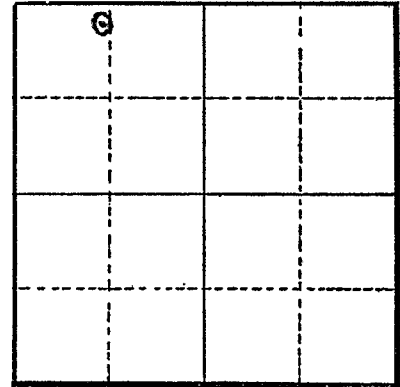

Section 20

Altitude at well 155 feet interpolated

TYPE OF WELL: Drilled Date Constructed May 1951

Depth drilled 106 Depth cased 106

CASING RECORD:

8 inch casing set from 0 to 106 feet

FINISH:

Perforations between 82 and 106 feet

AQUIFERS:

Sand from 82 to 106 feet

WATER LEVEL:

20 feet below land surface August 12, 1951

PUMPING EQUIPMENT: Type Fairbanks H.P. 3
Capacity 150 G.P.M.

WELL TESTS:

Drawdown ft. after hours pumping 150 G.P.M.

Drawdown ft. after hours G.P.M.

USE OF WATER Irrigation 7 acres Temp. °F., 19.....

SOURCE OF INFORMATION Registration Statement GR-244

DRILLER or DIGGER

ADDITIONAL DATA:

Log yes Water Level Measurements Chemical Analysis Aquifer Test

REMARKS:

