

STATE OF OREGON WATER SUPPLY WELL REPORT

Arrow 04-023

WELL ID # L 70240 START CARD # 166922

(as required by ORS 537.765)

(1) LAND OWNER:

Name: Newberg School District 29J Well Number: Address: 714 East 6th Street City: Newberg State: OR Zip: 97132

(2) TYPE OF WORK:

[X] New Well [ ] Deepening [ ] Alteration (repair/recondition) [ ] Abandonment

(3) DRILL METHOD:

[X] Rotary Air [ ] Rotary Mud [ ] Cable [ ] Auger [ ] Other:

(4) PROPOSED USE:

[ ] Domestic [X] Community [ ] Industrial [ ] Irrigation [ ] Thermal [ ] Injection [ ] Livestock [ ] Other

(5) BORE HOLE CONSTRUCTION:

Special Construction approval [ ] Yes [X] No

Depth of Completed Well 162'

Explosives Used [ ] Yes [X] No Type Amount

Table with columns: Diameter, From, To, Material, SEAL, sacks or pounds. Rows include bent chps, cement, 10", and 6" diameters.

How was seal placed: Method [ ] A [ ] B [X] C [ ] D [ ] E

[X] Other bent poured-probed

Backfill placed from to Material

Gravel placed from 103 to 180 Size of gravel 8-12 silica sand

(6) CASING/LINER:

CASING:

Table with columns: Diameter, From, To, Gauge, Steel, Plastic, Welded, Threaded. Rows for 6" diameters.

LINER:

Table with columns: Diameter, From, To, Gauge, Steel, Plastic, Welded, Threaded.

Drive Shoe used [ ] Inside [ ] Outside [X] None

Final location of Shoe(s):

(7) PERFORATIONS/SCREENS:

[ ] Perforations Method: [X] Screen Type: V-wire Material: stainless steel

Table with columns: From, To, Size, No., Diameter, Tele/pipe size, Casing, Liner. Rows for 124, 129, and 149 diameters.

(8) WELL TESTS: Minimum testing time is 1 hour

[ ] Pump [ ] Bailer [X] Air [ ] Flowing Artesian Yield gpm Drawdown Drill Stem at Time

Table with columns: Yield gpm, Drawdown, Drill Stem at, Time. Rows for 11 gpm tests.

Temperature of water 58 Depth Artesian Flow Found Was a water analysis done? yes By whom: Arrow/Always Pure Did any strata contain water not suitable for intended use? (explain) yes too shallow/no confining unit Depth of Strata: 11' to 54'

ARROW DRILLING 503-538-4422

(9) LOCATION OF WELL by legal description:

County: Yamhill Latitude: Longitude: Township: 3S Range: 3W Section: 9 NE 1/4 NE 1/4 Tax Lot: 1500 Lot: Block: Subdivision: Street Address of Well (or nearest address) 17600 NE North Valley Road, Newberg, Oregon 97132

(10) STATIC WATER LEVEL:

31 Ft. below land surface Date 9/3/04 Artesian pressure lb. per sq. in. Date


(11) WATER BEARING ZONES:

Table with columns: From, To, Est. Flow Rate, SWL. Rows for 15-54 and 125-160 depth ranges.

(12) WELL LOG:

Ground Elevation:

Table with columns: Material, From, To, SWL. Lists geological layers like top soil, clay, sandstone, etc.

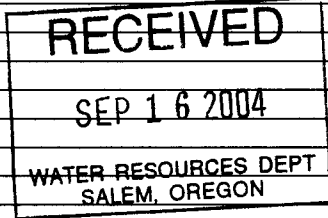

Date Started: 8/27/04 Completed: 9/3/04

(unbonded) Water Well Constructor Certification:

I certify that the work I performed on the construction, alteration, or abandonment of this well is in compliance with Oregon water supply well construction standards. Materials used and information reported above are true to the best of my knowledge and belief.

Signed Date WWC Number

(bonded) Water Well Constructor Certification:

I accept responsibility for the construction, alteration, or abandonment work performed on this well during the construction dates reported above. All work performed during this time is in compliance with Oregon water supply well construction standards. This report is true to the best of my knowledge and belief.

Signed Date WWC Number 1483 Date 9/8/04