

STATE ENGINEER
Salem, Oregon

YAMH
5404 Well Record

STATE WELL NO. 4/3W-21Q(1)
COUNTY Yamhill
APPLICATION NO. GR-26

OWNER: V. H. Thompson


MAILING
ADDRESS: _____

LOCATION OF WELL: Owner's No. 1

CITY AND
STATE: Dayton, Oregon

SW $\frac{1}{4}$ SE $\frac{1}{4}$ Sec. 21 T. 4 ^{N.} S., R. 3 ^{E.} W., W.M.

Bearing and distance from section or subdivision
corner 29 chains west and 1 rod north of
the SE corner of C. and P. Goodrich
DLC #49

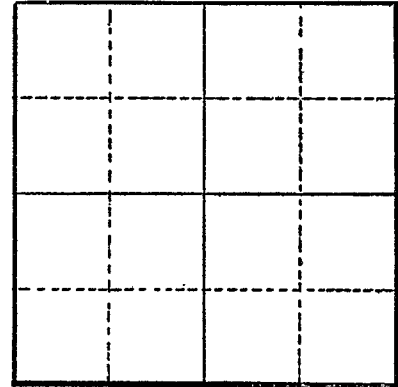

Section 21

Altitude at well 140 feet interpolated

TYPE OF WELL: Drilled Date Constructed Aug. '52

Depth drilled 160' Depth cased 160'

CASING RECORD:

8 inch casing set from 0 to 160 feet

FINISH:

3/8 inch lineal slots set from 80 to 160 feet.

AQUIFERS:

Sands, from 75 to 95 feet and from 135 to 160 feet

WATER LEVEL:

35 feet below land surface August 1952

PUMPING EQUIPMENT: Type Pomona Turbine 4" H.P. 25
Capacity 300 G.P.M.

WELL TESTS:

Drawdown 80 ft. after _____ hours 350 G.P.M.
Drawdown _____ ft. after _____ hours _____ G.P.M.

USE OF WATER Irrigation 55 acres Temp. _____ °F., 19 _____

SOURCE OF INFORMATION Registration Statement GR-26

DRILLER or DIGGER Wilcox Drilling Co. McMinnville, Oregon

ADDITIONAL DATA:

Log Water Level Measurements Chemical Analysis _____ Aquifer Test _____

REMARKS:

