

Yamh

54042

STATE OF OREGON WATER SUPPLY WELL REPORT (as required by ORS 537.765)

(WELL I.D.)# L 72468

(START CARD) # 168783

Instructions for completing this report are on the last page of this form.

(1) OWNER: Well Number 3 Name Mark & Carolyn VanHoef Address 5380 SE Booth Bend Rd City McMinnville State OR Zip 97128

(2) TYPE OF WORK [X] New Well [] Deepening [] Alteration (repair/recondition) [] Abandonment

(3) DRILL METHOD: [] Rotary Air [] Rotary Mud [] Cable [] Auger [X] Other Reverse Circulation Rotary

(4) PROPOSED USE: [] Domestic [] Community [] Industrial [X] Irrigation [] Thermal [] Injection [] Livestock [] Other

(5) BORE HOLE CONSTRUCTION: Special Construction approval [] Yes [X] No Depth of Completed Well 144.5 ft. Explosives used [] Yes [X] No Type Amount

Table with columns: HOLE Diameter, From, To, Material, SEAL From, To, Sacks or pounds. Includes entries for Bentonite and Cement.

How was seal placed: Method [] A [] B [X] C [] D [] E [] Other Backfill placed from 65 ft. to 150 ft. Material Gravel placed from 65 ft. to 150 ft. Size of gravel 6x9 & 8x12

(6) CASING/LINER: Table with columns: Diameter, From, To, Gauge, Steel, Plastic, Welded, Threaded. Includes entries for Casing and Liner.

Final location of shoe(s)

(7) PERFORATIONS/SCREENS: Table with columns: From, To, Slot size, Number cont, Diameter, Tele/pipe size, Casing, Liner. Includes entries for Screens.

(8) WELL TESTS: Minimum testing time is 1 hour [X] Pump [] Bailer [] Air [] Flowing Artesian Yield gal/min Drawdown Drill stem at Time

Temperature of water ~55F Depth Artesian Flow Found Was a water analysis done? [] Yes By whom Did any [] Salty [] Muddy [] Odor [] Colored [] Other Depth of strata: MAY 04 2005

(9) LOCATION OF WELL by legal description: County Yamhill Latitude Longitude Township 4 S Range 4 W WM. Section 28 SE 1/4 SE 1/4 Tax Lot 900 Lot Block Subdivision Street Address of Well (or nearest address) 5740 SE Booth Bend Rd McMinnville, OR

(10) STATIC WATER LEVEL: 35 ft. below land surface. Date 2/24/05 Artesian pressure lb. per square inch. Date

(11) WATER BEARING ZONES: Depth at which water was first found ~52

Table with columns: From, To, Estimated Flow Rate, SWL. Includes entries for 52, 93, and 113.

(12) WELL LOG: Ground Elevation

Table with columns: Material, From, To, SWL. Lists various soil and sediment layers with depths.

Date started 1/28/05 Completed 2/25/05

(unbonded) Water Well Constructor Certification: I certify that the work I performed on the construction, alteration, or abandonment of this well is in compliance with Oregon water supply well construction standards.

Signed [Signature] WWC Number 1367 Date 3/14/05

(bonded) Water Well Constructor Certification: I accept responsibility for the construction, alteration, or abandonment work performed on this well during the construction dates reported above.

Signed [Signature] WWC Number 649 Date 3/14/05

ORIGINAL & FIRST COPY WATER RESOURCES DEPARTMENT SALEM, OREGON RECEIVED MAR 15 2005

SECOND COPY-CONSTRUCTOR THIRD COPY-CUSTOMER

OREGON PRIDE NURSERIES Well #3
150 GPM Constant Rate Pump Test beginning 2/21/05

RECEIVED


MAR 15 2005

WATER RESOURCES DEPT
SALEM, OREGON

YAMH 54042

WATER RESOURCES DEPT
SALEM, OREGON

MAY 04 2005

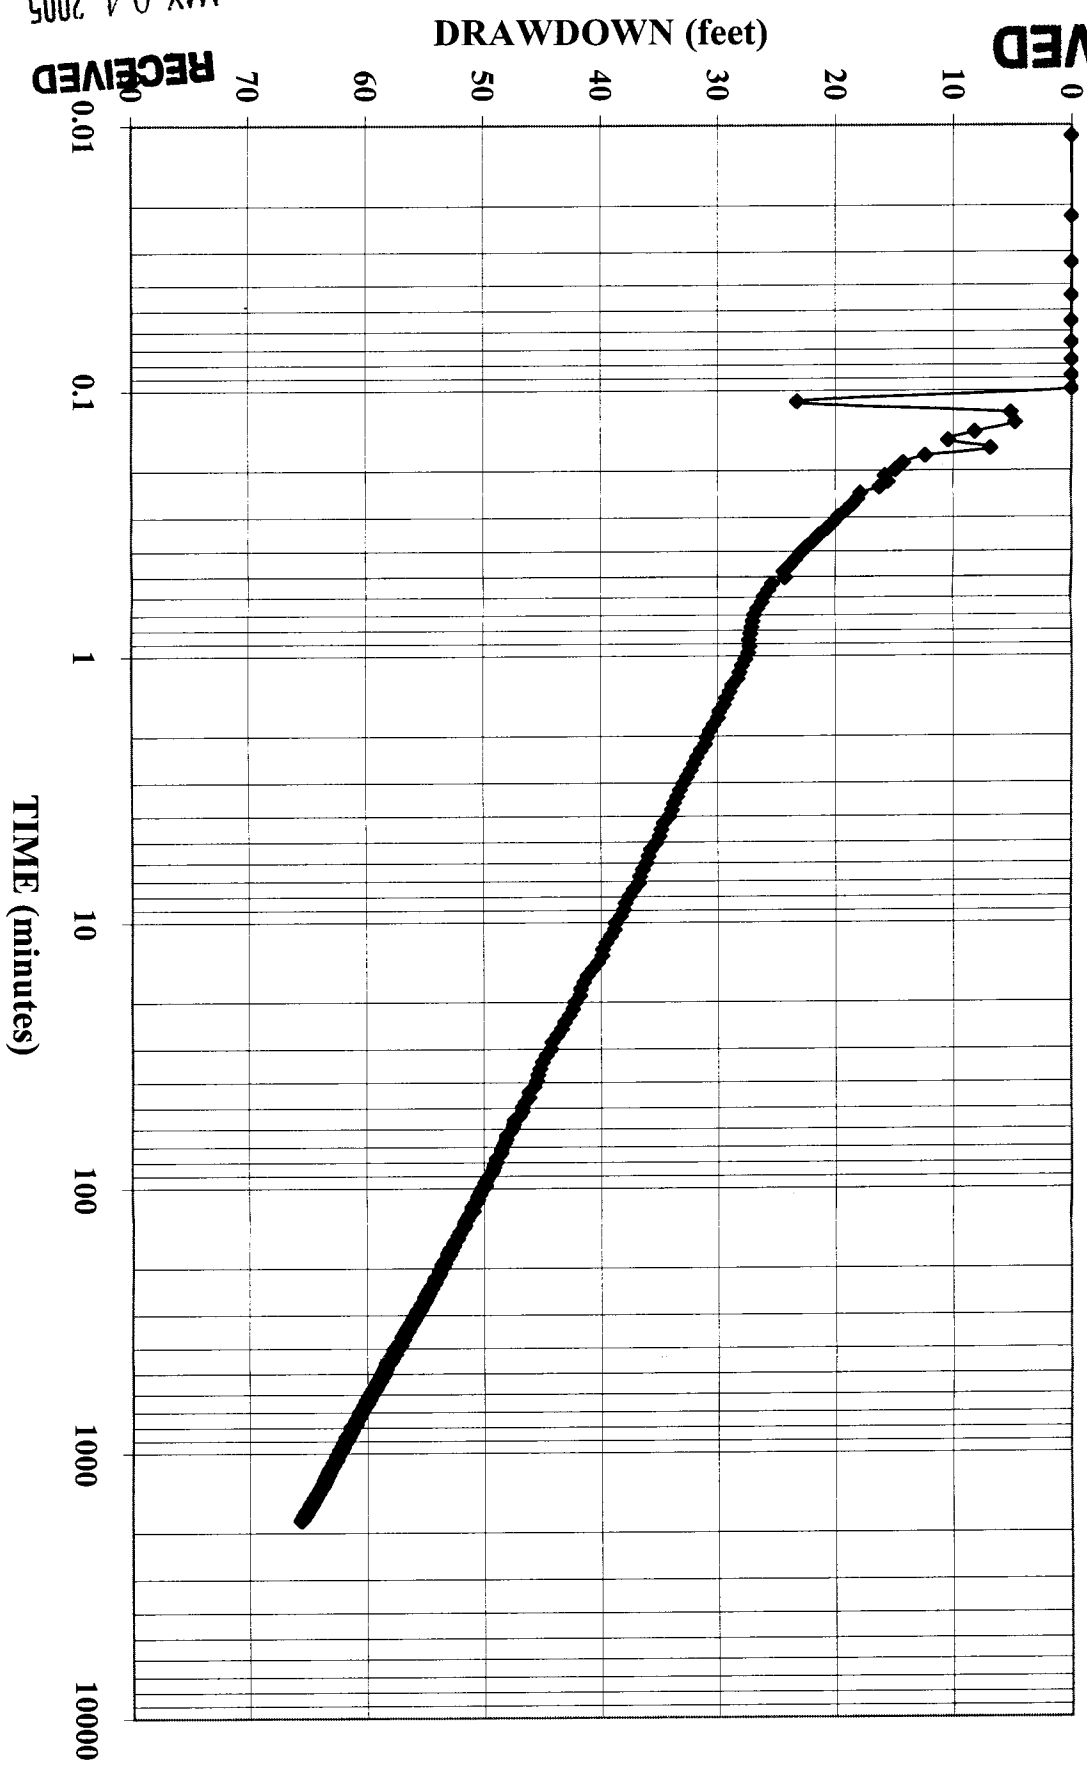

test data & graphs CR2 dd graph

Schneider Drilling Co.


MAR 15 2005

MAY 04 2005

RECEIVED

RECEIVED

OREGON PRIDE NURSERIES Well #3
Recovery from CR Pump Test begun on 2/21/05

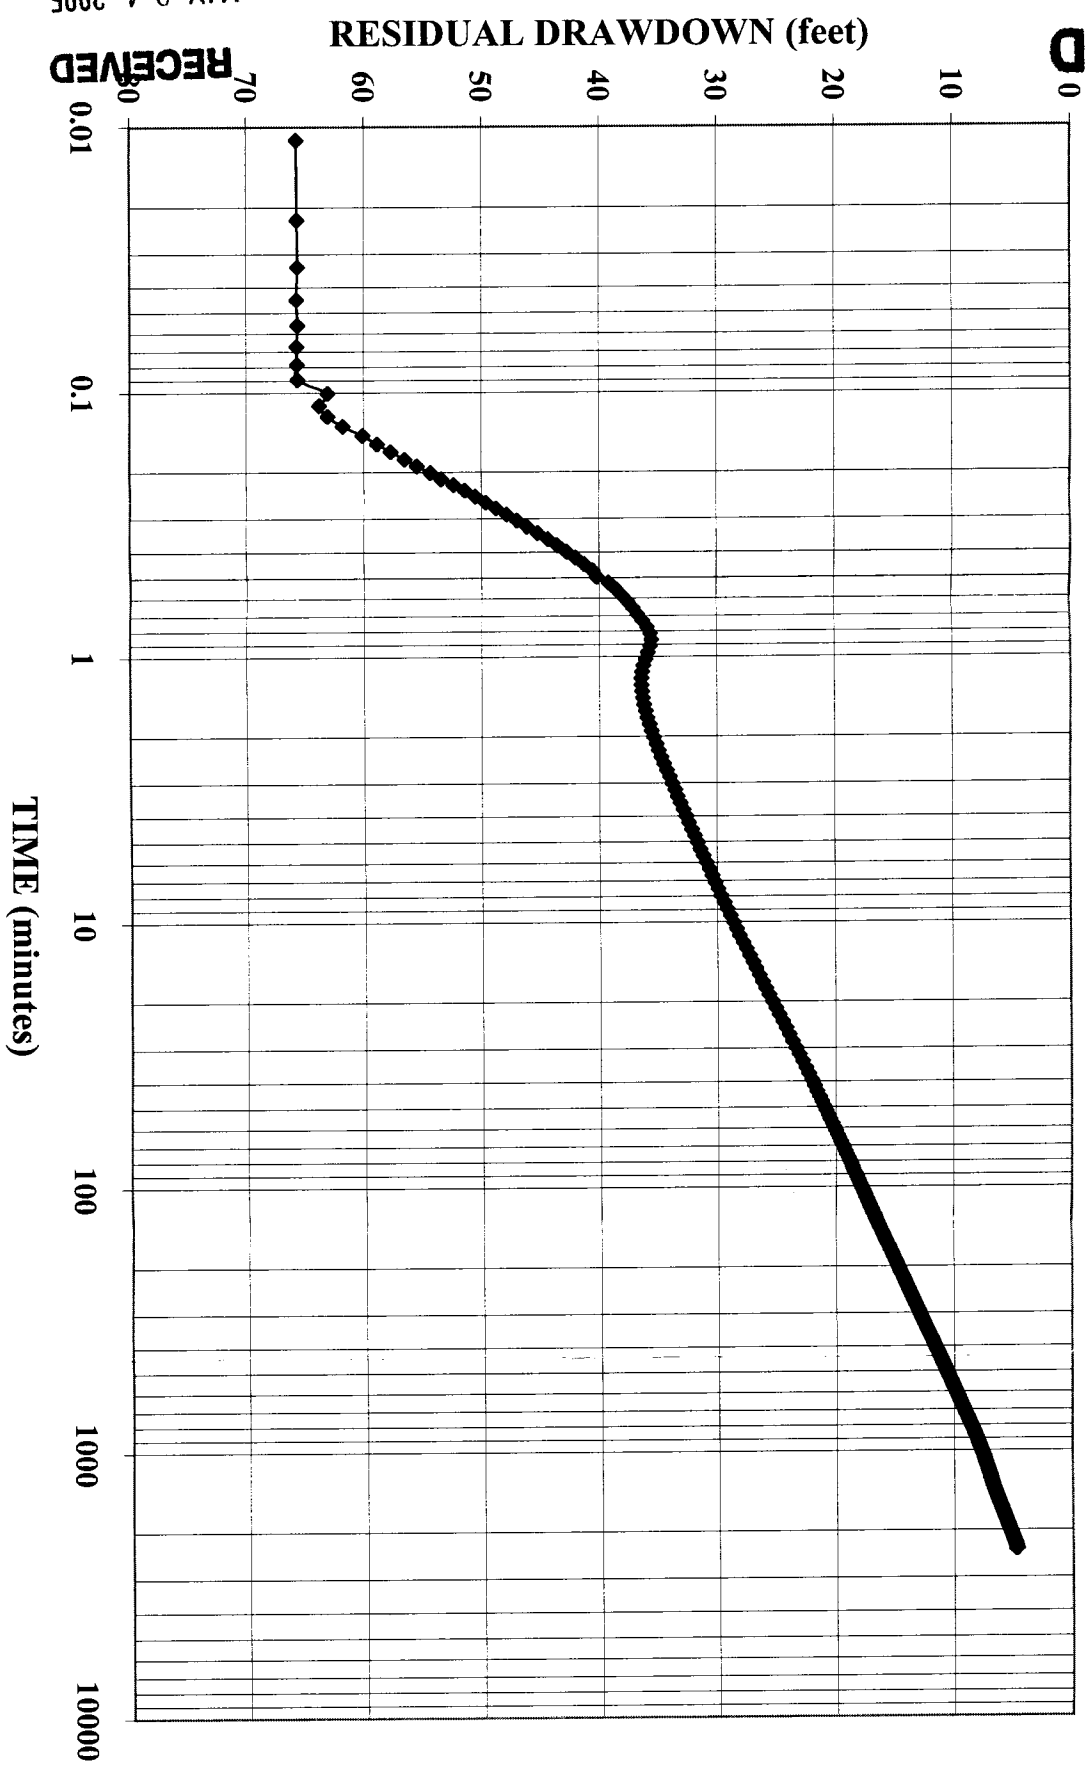

test data & graphs CR2 rec graph

Schneider Drilling Co.