

STATE ENGINEER  
Salem, Oregon

YAMHILL  
5405

# Well Record


STATE WELL NO. 4/3W-21Q(2)  
COUNTY Yamhill  
APPLICATION NO. GR-108

OWNER: Herman K. & Laurel J. Muder MAILING ADDRESS: \_\_\_\_\_

LOCATION OF WELL: Owner's No. 1 CITY AND STATE: Dayton, Oregon

SW 1/4 SE 1/4 Sec. 21 T. 4 N. S., R. 3 W., W.M.

Bearing and distance from section or subdivision corner 26 chains west and 4 chains north of SE corner of Section 21.

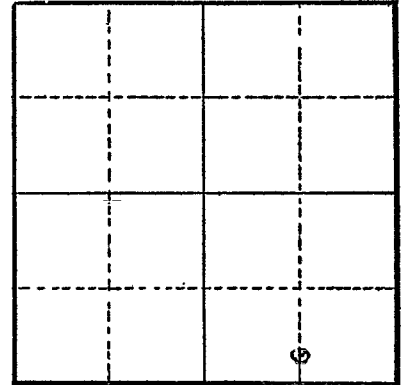

Section 21

Altitude at well 163 feet Interpolated

TYPE OF WELL: Drilled Date Constructed 6/16/52

Depth drilled 150 Depth cased 142

### CASING RECORD:

8 inch casing set from 0 to 142 feet

### FINISH:

8 rows perforations from 70 to 90 feet size 1/8 inch  
8 rows perforations from 120 to 142 feet size 1/8 inch

### AQUIFERS:

Sand and gravel from 120 to 142 feet

### WATER LEVEL:

20 feet below land surface 6/20/52

PUMPING EQUIPMENT: Type Pacific Turbine H.P. 20  
Capacity 375 G.P.M.

### WELL TESTS:

Drawdown 135 ft. after 375 hours G.P.M.  
Drawdown \_\_\_\_\_ ft. after \_\_\_\_\_ hours G.P.M.

USE OF WATER Irrigation 22 acres Temp. \_\_\_\_\_ °F., 19

SOURCE OF INFORMATION Registration Statement GR-108

DRILLER or DIGGER \_\_\_\_\_

### ADDITIONAL DATA:

Log  Water Level Measurements \_\_\_\_\_ Chemical Analysis \_\_\_\_\_ Aquifer Test \_\_\_\_\_

### REMARKS:

