

STATE ENGINEER
Salem, Oregon

YAMH Well Record

5418

STATE WELL NO. 4/3W-26N
COUNTY YAMHILL
~~APPLICATION NO. GR-2802~~

OWNER: Hubert L. Wilson


MAILING ADDRESS: Rt. 1, Box 250

LOCATION OF WELL: Owner's No. _____

CITY AND STATE: Dayton, Oregon

SW 1/4 SW 1/4 Sec. 26 T. 4 ~~N.~~ S., R. 3 ~~E.~~ W., W.M.

Bearing and distance from section or subdivision corner 590' N. and 170' E.

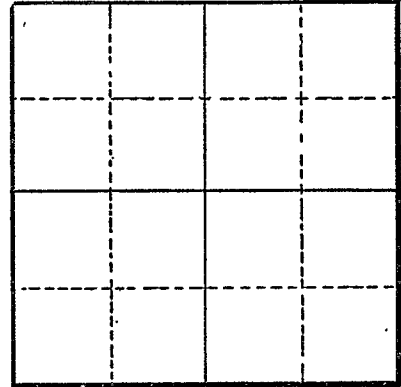

Section _____

Altitude at well _____

TYPE OF WELL: drilled Date Constructed 1955

Depth drilled 25 Depth cased 25

CASING RECORD:
12-inch

FINISH:

six 1/2" x 6" perforations per foot from 15 to 25

AQUIFERS:

Topsoil, clay, sand and gravel

WATER LEVEL:

5-feet

PUMPING EQUIPMENT: Type Fairbanks Morse Centrifugal H.P. 20

Capacity 450 G.P.M.

WELL TESTS:

Drawdown 10 ft. after _____ hours Pumping 500 G.P.M.

Drawdown _____ ft. after _____ hours _____ G.P.M.

USE OF WATER irrigation Temp. _____ °F., 19 _____

SOURCE OF INFORMATION GR-2644

DRILLER or DIGGER _____

ADDITIONAL DATA:

Log X Water Level Measurements _____ Chemical Analysis _____ Aquifer Test _____

REMARKS:

Topsoil	5	0	5
Sandy clay	6	5	11
Black sand	1	11	12
River gravel	13	12	25