

STATE ENGINEER
Salem, Oregon

Well Record
YAMHILL
5427

STATE WELL NO. 4/3W-27F(1)
COUNTY Yamhill
APPLICATION NO. GR-709

OWNER: T. E. Youngblood


MAILING ADDRESS: Route 1

LOCATION OF WELL: Owner's No. 1

CITY AND STATE: Dayton, Oregon

SE 1/4 NW 1/4 Sec. 27 T. 4 S., R. 3 W., W.M.

Bearing and distance from section or subdivision
corner 1420 feet east and 300 feet north from
W 1/4 corner Section 27

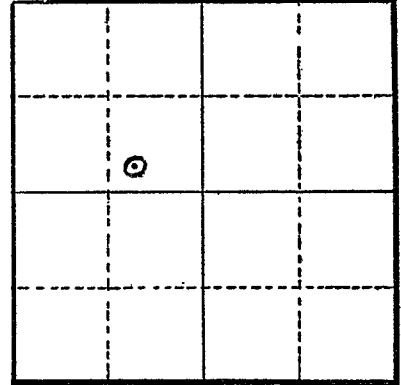

Section 27

Altitude at well 155 feet Interpolated

TYPE OF WELL: Drilled Date Constructed 6/25/55

Depth drilled 148' Depth cased 148'

CASING RECORD:

6 inch

FINISH:

AQUIFERS:

WATER LEVEL:

32 feet

PUMPING EQUIPMENT: Type Montgomery Ward Jet H.P. 5
Capacity 75 G.P.M.

WELL TESTS:

Drawdown 60 ft. after _____ hours 125 G.P.M.
Drawdown _____ ft. after _____ hours _____ G.P.M.

USE OF WATER Irrigation 10.6 acres Temp. _____ °F., 19 _____

SOURCE OF INFORMATION GR-709

DRILLER or DIGGER J. H. Meeker; Newberg, Oregon

ADDITIONAL DATA:

Log Water Level Measurements _____ Chemical Analysis _____ Aquifer Test _____

REMARKS:

