

STATE ENGINEER  
Salem, Oregon

*YAMH*  
*5428*  
**Well Record**


STATE WELL NO. 4/3W-27J  
COUNTY YAMHILL  
~~APPLICATION NO. GR-2573~~

OWNER: George L. Dorsey & Gladys L. Dorsey MAILING ADDRESS: # 251 RDI

LOCATION OF WELL: Owner's No. \_\_\_\_\_ CITY AND STATE: Dayton, Oregon

NE 1/4 SE 1/4 Sec. 27 T. 4 N S., R. 3 E W., W.M.

Bearing and distance from section or subdivision corner 1450' N. & 600' W.

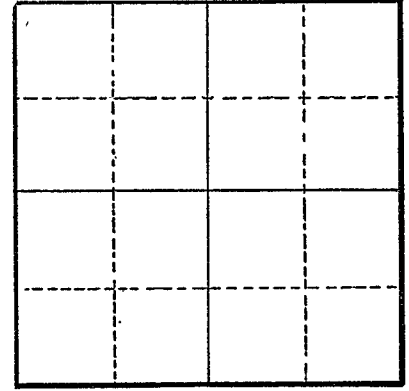

Section \_\_\_\_\_

Altitude at well \_\_\_\_\_

TYPE OF WELL: Drilled Date Constructed \_\_\_\_\_

Depth drilled 24 Depth cased 23

CASING RECORD:

12-inch

FINISH:

Perforations from 11 to 23

AQUIFERS:

Sand, Gravel and soil

WATER LEVEL:

8 to 9 feet

PUMPING EQUIPMENT: Type Centrifugal H.P. 22  
Capacity 250 G.P.M.

WELL TESTS:

Drawdown 6 ft. after \_\_\_\_\_ hours Pumping 250 G.P.M.  
Drawdown \_\_\_\_\_ ft. after \_\_\_\_\_ hours \_\_\_\_\_ G.P.M.

USE OF WATER Irrigation Temp. \_\_\_\_\_ °F. \_\_\_\_\_, 19

SOURCE OF INFORMATION GR-2432

DRILLER or DIGGER \_\_\_\_\_

ADDITIONAL DATA:

Log  Water Level Measurements \_\_\_\_\_ Chemical Analysis \_\_\_\_\_ Aquifer Test \_\_\_\_\_

REMARKS:

Sand & Soil 7  
Gravel and sand 16