

STATE ENGINEER
Salem, Oregon

YAMH Well Record
5429

STATE WELL NO. 4/3W-27L
COUNTY YAMHILL
APPLICATION NO. GR-2801

OWNER: Hubert L. Wilson


MAILING ADDRESS: Rt. 1, Box 250

LOCATION OF WELL: Owner's No.

CITY AND STATE: Dayton, Oregon

NE 1/4 SW 1/4 Sec. 27 T. 4 N S, R. 3 E W, W.M.

Bearing and distance from section or subdivision corner 2385' N. and 175' W.

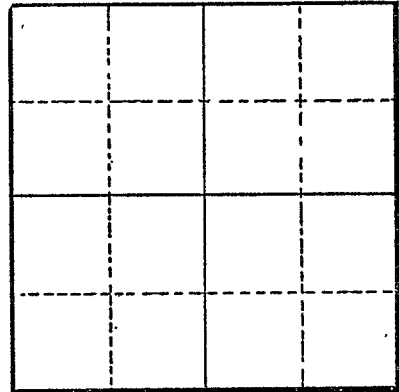

Section

Altitude at well

TYPE OF WELL: drilled Date Constructed 1954

Depth drilled 125 Depth cased 123

CASING RECORD:

12-inch

FINISH:

Six 1/2" x 6" perforations per foot from 55 to 116

AQUIFERS:

Clay, sand and gravel

WATER LEVEL:

30-feet

PUMPING EQUIPMENT: Type Fairbanks Morse Turbine H.P. 5

Capacity 140 G.P.M.

WELL TESTS:

Drawdown 43 ft. after hours Pumping 80 G.P.M.

Drawdown ft. after hours G.P.M.

USE OF WATER irrigation Temp. °F., 19

SOURCE OF INFORMATION GR-2643

DRILLER or DIGGER

ADDITIONAL DATA:

Log X Water Level Measurements Chemical Analysis Aquifer Test

REMARKS:

