

YAMH 54374

State of Oregon
WATER WELL REPORT (as required by ORS 537.765)

Page 1 of 2

State Well ID L82379
Start Card # 184146

(1) OWNER: Well No. 2424
Name MONROVIA NURSERY CO.
Address 13455 SE LAFAYETTE HWY
City DAYTON St OR Zip 97114

(2) TYPE OF WORK: Alteration

(3) DRILL METHOD: CABLE

(4) PROPOSED USE: IRRIGATION

(5) BORE HOLE CONSTRUCTION:

Special Construction	Approval NO	Depth of Compl. Well	190 ft
Explosives used	NO	Type	Amount
HOLE SEAL			
Diam.	From	To	Material
12	0	160	BENTONITE CHIP
8	160	190	ANNULAR BACFIL
			W/BENTONITE CHI
			50 112 79 SAX

Seal placement method POURED/PROBED
Backfill: from ___ ft to ___ ft Material
Gravel: from 112 ft to 160 ft Size 3/8" PEA

(6) CASING/LINER:

Diam.	From	To	Gauge	Material	Connection
Casing 8	+1	190	.25	STEEL	WELDED
Liner					

Final Location of shoe(s) 190

(7) PERFORATIONS/SCREENS:

From	To	Slot Size	Number	Diam.	Tele/pipe Size	Casing/liner
145	185	.2X8"	175			CASING
145	185	.2X4"	80			CASING

[X] Perf. Method TORCH
[] Screens Type _____ Material _____

(8) WELL TESTS: Minimum testing time is 1 hour
Test type AIR

Yield GPM	Draw-down	Drill stem at	Time
500		188	1 hr.
500		188	23

Temperature of water 53F Depth Artesian Flow Found _____
Was water analysis done? YES By whom TDS 94PPM
Reason for water not suitable for use _____
Depth of strata _____

(9) LOCATION OF WELL by legal description:
County YAMHILL Lat. ' ' ' Long. ' ' '
Township 4 S Range 3 W WM.
Section 31 SW 1/4 SE 1/4
Tax Lot R5306 Lot 300 Block _____ Subdivision _____
Street Address of Well (or nearest Address)
13455 SE LAFAYETTE HWY DAYTON, OR

(10) STATIC WATER LEVEL:
28 ft. below land surface. Date 03/13/06
Artesian pressure _____ lb per square in. Date _____

(11) WATER BEARING ZONES:

Depth at which water was first found	SWL	Est Flow Rate	SWL
From	To		
SWL	183	500	28


(12) WELL LOG:

Material	Ground elevation		SWL
	From	To	
FILL	0	4	
TOP SOIL	4	6	
CLAY, BROWN SILTY	6	25	
CLAY, GRAY SILTY	25	36	
SAND, BROWN FINE W/ SOME CLAY	36	42	
CLAY, GRAY SILTY W/SOME SAND	42	51	
CLAY, GRAY SOFT	51	58	
CLAY, GREEN/GRAY W/FINE SAND	58	65	
SAND, GREEN/GRAY W/SOME CLAY	65	72	
CLAY, GRAY W/SAND	72	91	
CLAY, GRAY SOFT	91	98	
CLAY, W/FINE GRAVEL AND SAND	98	103	
CLAY, GRAY SOFT	103	107	
CLAY, BROWN	107	110	
CLAY, BROWN AND GRAY	110	121	
SAND, GREEN W/SOME BROWN	121	131	

....CONTINUED ON PAGE 2....
Date started 01/24/06 Completed 03/13/06

(unbonded) Water Well Constructor Certification: I certify that the work I performed on the construction, alteration, or abandonment of this well is in compliance with Oregon water supply well construction standards. Materials used and information reported above are true to my best knowledge and belief.
Signed _____ WWC Number _____
Date _____

(bonded) Water Well Constructor Certification: I accept responsibility for the construction, alteration, or abandonment work performed on this well during the construction dates reported above. All work performed during this time is in compliance with Oregon water supply well construction standards. This report is true to the best of my knowledge and belief.
Signed David B. Payson WWC Number 1438
Date 03/13/06

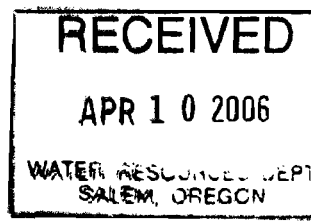

YAMH 54374

State of Oregon
WATER WELL REPORT (as required by ORS 537.765)

Page 2 of 2

State Well ID L82379
Start Card # 184146

(1) OWNER: Well No. 2424
Name MONROVIA NURSERY CO.
Address 13455 SE LAFAYETTE HWY
City DAYTON St OR Zip 97114

(2) TYPE OF WORK: Alteration
(3) DRILL METHOD: CABLE
(4) PROPOSED USE: IRRIGATION

(5) BORE HOLE CONSTRUCTION:
Special Construction Approval NO _____ Depth of Compl. Well 190 ft
Explosives used NO _____ Type _____ Amount _____
HOLE SEAL
Diam. From To Material From To Amount
12 0 160 BENTONITE CHIP 0 50 66 SAX
8 160 190 ANNULAR BACFIL _____
W/BENTONITE CHI 50 112 79 SAX
Seal placement method POURED/PROBED
Backfill: from _____ ft to _____ ft Material _____
Gravel: from 112 ft to 160 ft Size 3/8" PEA

(6) CASING/LINER:
Diam. From To Gauge Material Connection
Casing 8 +1 190 .25 STEEL WELDED
Liner _____
Final Location of shoe(s) 190

(7) PERFORATIONS/SCREENS:
 Perf. Method TORCH
 Screens Type _____ Material _____
Slot Tele/pipe
From To Size Number Diam. Size Casing/liner
145 185 .2X8" 175 _____ CASING
145 185 .2X4" 80 _____ CASING


(8) WELL TESTS: Minimum testing time is 1 hour
Test type AIR
Yield GPM Draw-down Drill stem at Time
500 _____ 188 1 hr.
500 _____ 188 23
Temperature of water 53F Depth Artesian Flow Found _____
Was water analysis done? YES By whom TDS 94PPM
Reason for water not suitable for use _____
Depth of strata _____

(9) LOCATION OF WELL by legal description:
County YAMHILL Lat. ' ' ' ' Long. ' ' ' '
Township 4 S Range 3 W WM.
Section 31 SW 1/4 SE 1/4
Tax Lot R5306 Lot 300 Block _____ Subdivision _____
Street Address of Well (or nearest Address)
13455 SE LAFAYETTE HWY DAYTON, OR

(10) STATIC WATER LEVEL:
28 ft. below land surface. Date 03/13/06
Artesian pressure _____ lb per square in. Date _____

(11) WATER BEARING ZONES:
Depth at which water was first found SWL
From To Est Flow Rate SWL
SWL 183 500 28

(12) WELL LOG:
Material Ground elevation From To SWL
...CONTIUED FROM PAGE 1
CLAY, GRAY SOFT W/SOME SAND 131 144
GRAVEL, FINE W/SAND BLACK AND BROWN, MED 144 183
CLAY, GRAY 183 190
DAVE PAYSINGER, BLUE WATER DRILLING CO.
(503) 868-7878
Date started 01/24/06 Completed 03/13/06

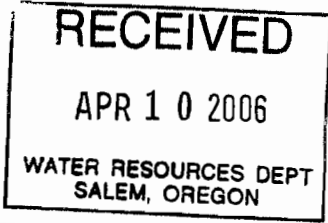

(unbonded) Water Well Constructor Certification: I certify that the work I performed on the construction, alteration, or abandonment of this well is in compliance with Oregon water supply well construction standards. Materials used and information reported above are true to my best knowledge and belief.
Signed _____ WWC Number _____
Date _____

(bonded) Water Well Constructor Certification: I accept responsibility for the construction, alteration, or abandonment work performed on this well during the construction dates reported above. All work performed during this time is in compliance with Oregon water supply well construction standards. This report is true to the best of my knowledge and belief.
Signed David S. Paysinger WWC Number 1438
Date 03/13/06