

STATE ENGINEER
Salem, Oregon

YAMHILL
5443

Well Record

STATE WELL NO. 4/3W-28D(1)
COUNTY Yamhill
APPLICATION NO. GR-179

OWNER: Jack C. Edwards

MAILING ADDRESS:

Route 2, Box 13


LOCATION OF WELL: Owner's No. #1

CITY AND STATE:

Dayton, Oregon

N. E.
NW 1/4 NW 1/4 Sec. 28 T. S., R. W., W.M.

Bearing and distance from section or subdivision corner 2390 feet north and 2590 feet east of SW corner of Joel Chrisman DLC

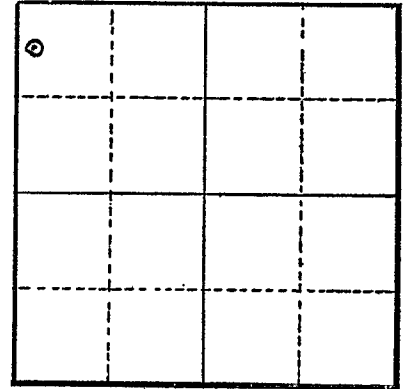

Section 28

Altitude at well 157 feet Interpolated

TYPE OF WELL: Drilled Date Constructed 4/1/54

Depth drilled 227 Depth cased 227

CASING RECORD:

10 inch casing set from 0 to 227 feet

FINISH:

No record

AQUIFERS:

Unknown

WATER LEVEL:

22 feet below land surface

PUMPING EQUIPMENT: Type Pomona Turbine H.P. 10
Capacity 300 G.P.M.

WELL TESTS:

Drawdown 20 ft. after pumping 140 G.P.M.
Drawdown 38 ft. after pumping 220 G.P.M.

USE OF WATER Irrigation 35 acres Temp. °F. 19

SOURCE OF INFORMATION Registration Statement GR-179

DRILLER or DIGGER H. A. Bottner Portland, Oregon

ADDITIONAL DATA:

Log No Water Level Measurements Chemical Analysis Aquifer Test

REMARKS: