

STATE ENGINEER
Salem, Oregon

*YAMH
5465*

Well Record

STATE WELL NO. 4/3W-31P
COUNTY Yamhill
APPLICATION NO. GR-1696


GR- 1645

OWNER: Wilhelm A. Paulson MAILING ADDRESS: Rt. 1, Box 28

LOCATION OF WELL: Owner's No. _____ CITY AND STATE: Dayton, Oregon

SE 1/4 SW 1/4 Sec. 31 T. 4 S., R. 3 W., W.M.

Bearing and distance from section or subdivision
corner 501' N. & 1772' E. from SW cor. Sec. 31

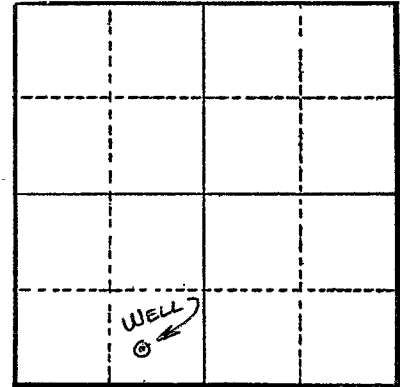

Section 31

Altitude at well 137'

TYPE OF WELL: Drilled Date Constructed 1951

Depth drilled 116' Depth cased 116'

CASING RECORD:
8"

FINISH:

48 perforations 12" x 1/4" 8" long from 84 to 90 ft.
96 perforations 12" x 1/4" 8" long from 105 to 116 ft.

AQUIFERS:

WATER LEVEL:
20'

PUMPING EQUIPMENT: Type Jacuzzi line shaft turbine H.P. 7 1/2
Capacity 130 G.P.M.

WELL TESTS:
Drawdown 90 ft. after _____ hours 130 G.P.M.
Drawdown _____ ft. after _____ hours _____ G.P.M.

USE OF WATER Irrigation Temp. _____ °F. _____, 19____

SOURCE OF INFORMATION GR Record

DRILLER or DIGGER Wilcox

ADDITIONAL DATA:
Log _____ Water Level Measurements _____ Chemical Analysis _____ Aquifer Test _____

REMARKS:

Log: Top soil 0 to 2 ft.
Clay & silty clay 2 to 21 ft.
Blue clay 21 to 46 ft.
Silt 46 to 73 ft.
Fine black sand 73 to 76 ft.
Blue clay 76 to 84 ft.
Black sand 84 to 90 ft.
Blue clay 90 to 108 ft.
Sand & fine gravel 108 to 116 ft.
Irrigation of 41 acres.