

STATE ENGINEER
Salem, Oregon

YAMH Well Record

5475

STATE WELL NO. 4/3W-32N(1)
COUNTY Yamhill
APPLICATION NO. GR-229

OWNER: Richard M. Lofton


MAILING ADDRESS: 1350 Malone Avenue

LOCATION OF WELL: Owner's No. #1

CITY AND STATE: McMinnville, Oregon

SW 1/4 SW 1/4 Sec. 32 T. 4 N. S, R. 3 E. W., W.M.

Bearing and distance from section or subdivision corner 3.95 chains east of section line between Sections 31 and 32 and 240 feet north of SE corner of Mary Jeffrey's DLC

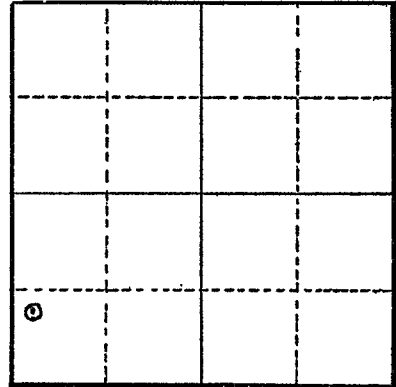

Section 32

Altitude at well 155 feet Interpolated

TYPE OF WELL: Drilled Date Constructed Nov. '51

Depth drilled 125 Depth cased 125

CASING RECORD:

8 inch casing set from 0 to 125 feet

FINISH:

Perforated from 70 to 125 feet

AQUIFERS:

Sand and gravel 70 to 125 feet

WATER LEVEL:

40 feet below land surface

PUMPING EQUIPMENT: Type Pomona Water Lub. Turbine 5" H.P. 15
Capacity 250 G.P.M. at 180' of head

WELL TESTS:

Drawdown 65 ft. after _____ hours pumping 250 G.P.M.
Drawdown 80 ft. after _____ hours pumping 350 G.P.M.

USE OF WATER Irrigation 40 acres Temp. _____ °F., 19 _____

SOURCE OF INFORMATION Registration Statement GR-229

DRILLER or DIGGER Wilcox Drilling Co.

ADDITIONAL DATA:

Log yes Water Level Measurements _____ Chemical Analysis _____ Aquifer Test _____

REMARKS:

