

STATE ENGINEER
Salem, Oregon

YAMHILL Well Record
5489


STATE WELL NO. 4/3W-34
COUNTY Yamhill
APPLICATION NO. _____

OWNER: Nichols Bros. MAILING ADDRESS: Rt. 1

LOCATION OF WELL: Owner's No. _____ CITY AND STATE: Dayton, Oregon

1/4 1/4 Sec. 34 T. 4 S., R. 3 W., W.M.

Bearing and distance from section or subdivision corner _____

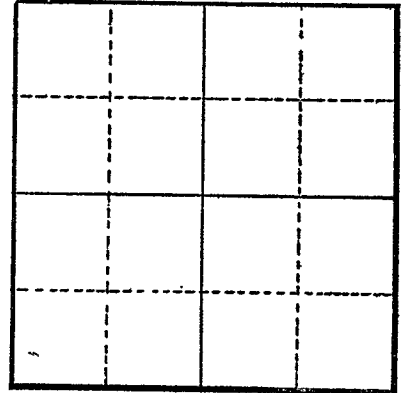

Section 34

Altitude at well _____

TYPE OF WELL: Drilled Date Constructed 1948

Depth drilled 47 ft. Depth cased _____

CASING RECORD:
10 inch

FINISH:

AQUIFERS:

WATER LEVEL:
8 ft.

PUMPING EQUIPMENT: Type Centrifugal H.P. 40
Capacity 500 G.P.M.

WELL TESTS:
Drawdown 15 ft. after _____ hours 550 G.P.M.
Drawdown _____ ft. after _____ hours _____ G.P.M.

USE OF WATER Irrigation Temp. _____ °F., 19 _____

SOURCE OF INFORMATION Related registration statement

DRILLER or DIGGER _____

ADDITIONAL DATA:
Log _____ Water Level Measurements _____ Chemical Analysis _____ Aquifer Test _____

REMARKS:

Log: Clay 0 to 23 ft.
Sand 23 to 33 ft.
Gravel 33 to 47 ft.

Irrigation of 150 acres.