

STATE ENGINEER
Salem, Oregon

YAMHILL
5499
Well Record

STATE WELL NO. 4/3W-35E
COUNTY YAMHILL
APPLICATION NO. GR-4171

OWNER: John Michael, Jr.


MAILING ADDRESS: Rt 1 Box 220

LOCATION OF WELL: Owner's No. _____

CITY AND STATE: Dayton, Oregon

SW NE SE 1/4 NW 1/4 Sec. 35 T. 4 S., R. 3 W., W.M.

Bearing and distance from section or subdivision corner 1915' S & 110' E from NW cor. Sec. 35

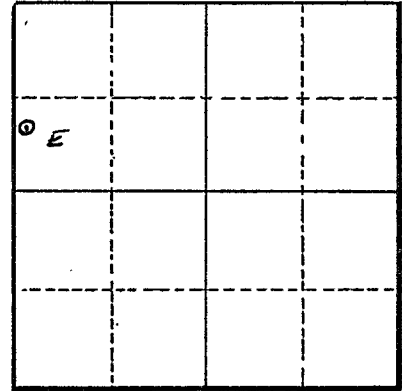

Section 35

Altitude at well _____

TYPE OF WELL: Drilled Date Constructed 1943

Depth drilled 42' Depth cased 42'

CASING RECORD:

12-inch

FINISH:

AQUIFERS:

WATER LEVEL:

3' to 8'

PUMPING EQUIPMENT: Type Fairbanks Morse H.P. _____

Capacity _____ G.P.M.

WELL TESTS:

Drawdown 15 ft. after _____ hours 650 G.P.M.

Drawdown _____ ft. after _____ hours _____ G.P.M.

USE OF WATER Irrigation Temp. _____ °F., 19_____

SOURCE OF INFORMATION GR-3971

DRILLER or DIGGER Williamette Drilling Co.

ADDITIONAL DATA:

Log NA Water Level Measurements _____ Chemical Analysis _____ Aquifer Test _____

REMARKS: