

STATE ENGINEER
Salem, Oregon

YAMH Well Record
5530

STATE WELL NO. 4/4W-1N(1)
COUNTY Yamhill
APPLICATION NO. GR-112

OWNER: F. H. Bourland


MAILING ADDRESS: 1001 E. 3rd Street

LOCATION OF WELL: Owner's No. #1

CITY AND STATE: Newberg, Oregon

SW 1/4 SW 1/4 Sec. 1 T. 4 N. S., R. 4 W., W.M.

Bearing and distance from section or subdivision corner 3272 feet east and 436 feet north of the most westerly SW corner of the Millican DLC

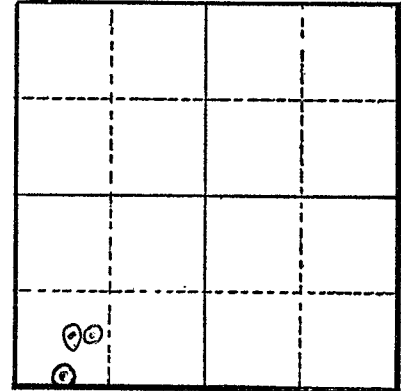

Section 1

Altitude at well 62 feet Interpolated

TYPE OF WELL: Drilled Date Constructed 5/22/54

Depth drilled 79 Depth cased 79

CASING RECORD:

6 inch casing set from 0 to 79 feet

FINISH:

Perforations between 71 to 77 feet

AQUIFERS:

Sand and gravel from 57 to 79 feet

WATER LEVEL:

57 feet below land surface

PUMPING EQUIPMENT: Type Jacuzzi

H.P.

Capacity 28 G.P.M.

WELL TESTS:

Drawdown 18 ft. after 20 hours G.P.M.

Drawdown ft. after hours G.P.M.

USE OF WATER Irrigation 29 acres Temp. °F., 19

SOURCE OF INFORMATION Registration Statement GR-112

DRILLER or DIGGER E. L. Koeneman

ADDITIONAL DATA:

Log Water Level Measurements Chemical Analysis Aquifer Test

REMARKS:

