

STATE ENGINEER
Salem, Oregon

YAMH Well Record

5531

STATE WELL NO. 4/4W-1N(2)
COUNTY Yamhill
APPLICATION NO. GR-112

OWNER: F. H. Bourland


MAILING ADDRESS: 1001 E. 3rd St.

LOCATION OF WELL: Owner's No. #2

CITY AND STATE: Newberg, Oregon

SW 1/4 SW 1/4 Sec. 1 T. 4 S., R. 4 W., W.M.

Bearing and distance from section or subdivision corner 3755 east and 1016 north of the most westerly SW corner of the Millican DLC

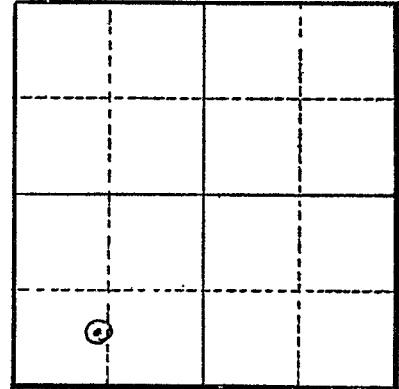

Section 1

Altitude at well 57 feet Interpolated

TYPE OF WELL: Drilled Date Constructed 2/9/55

Depth drilled 88 Depth cased 88

CASING RECORD:

6 inch casing set from 0 to 88 feet

FINISH:

None

AQUIFERS:

Shale and sandstone from 60 to 70 feet

WATER LEVEL:

60 feet below land surface

PUMPING EQUIPMENT: Type Jacuzzi H.P. 3/4
Capacity 28 G.P.M.

WELL TESTS:

Drawdown 20 ft. after _____ hours 20 G.P.M.
Drawdown _____ ft. after _____ hours _____ G.P.M.

USE OF WATER Irrigation 29 acres Temp. _____ °F, 19

SOURCE OF INFORMATION Registration Statement GR-112

DRILLER or DIGGER E. L. Koeneman

ADDITIONAL DATA:

Log Water Level Measurements _____ Chemical Analysis _____ Aquifer Test _____

REMARKS:

