

STATE ENGINEER
Salem, Oregon

YAMHILL Well Record

5532


STATE WELL NO. 4/4W-1N(3)
COUNTY Yamhill
APPLICATION NO. GR-112

OWNER: F. H. Bourland MAILING ADDRESS: 1001 E. 3rd St.

LOCATION OF WELL: Owner's No. #3 CITY AND STATE: Newberg, Oregon

SW 1/4 Sec. 1 T. 4 S., R. 4 W., W.M.

Bearing and distance from section or subdivision corner 3500 feet east and 746 feet north of the most westerly NW corner of the Millican DLC

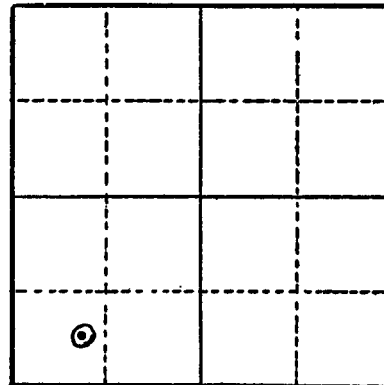

Section 1

Altitude at well 59 feet Interpolated

TYPE OF WELL: Drilled Date Constructed 6/2/55

Depth drilled 77 Depth cased 77

CASING RECORD:

6 inch casing set from 0 to 77 feet

FINISH:

Gravel pack

AQUIFERS:

Sand from 47 to 62 feet

WATER LEVEL:

62 feet below land surface

PUMPING EQUIPMENT: Type Turbine to be purchased soon H.P. _____
Capacity _____ G.P.M.

WELL TESTS:

Drawdown 13 ft. after _____ hours 40 G.P.M.
Drawdown _____ ft. after _____ hours _____ G.P.M.

USE OF WATER Irrigation 29 acres Temp. _____ °F., 19 _____

SOURCE OF INFORMATION Registration Statement GR-112

DRILLER or DIGGER E. L. Koeneman

ADDITIONAL DATA:

Log Water Level Measurements _____ Chemical Analysis _____ Aquifer Test _____

REMARKS:

