

STATE ENGINEER
Salem, Oregon

YAMH
5649

Well Record

GR- 1378

STATE WELL NO. 4/4N.10A
COUNTY Yamhill
APPLICATION NO. GR- 1424

OWNER: Matt Van Laanen

MAILING ADDRESS:

Rt. 2, Box 139

LOCATION OF WELL: Owner's No.


CITY AND STATE:

McMinnville, Oregon

NE 1/4 NE 1/4 Sec. 10 T. 4 S., R. 4 W., W.M.

Bearing and distance from section or subdivision

corner 110' S. & 100' W. from NE cor. Sec. 10

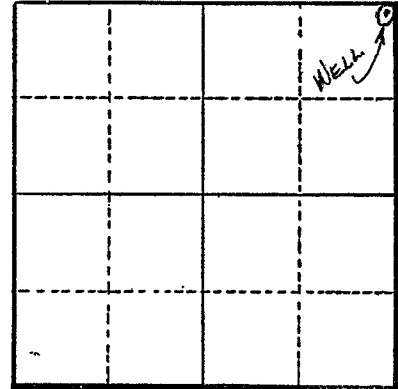

Section 10

Altitude at well

TYPE OF WELL: Drilled Date Constructed 1951

Depth drilled 88' Depth cased 88'

CASING RECORD:

6"

FINISH:

Perforated from 77' to 88'

AQUIFERS:

WATER LEVEL:

77'

PUMPING EQUIPMENT: Type Pomona turbine

H.P. 5

Capacity 150 G.P.M.

WELL TESTS:

Drawdown 10 ft. after hours 120 G.P.M.

Drawdown ft. after hours G.P.M.

USE OF WATER Irrigation & Domestic Temp. °F., 19

SOURCE OF INFORMATION GR Record

DRILLER or DIGGER John Wilcox

ADDITIONAL DATA:

Log N.A. Water Level Measurements Chemical Analysis Aquifer Test

REMARKS:

Irrigation of 12 acres.