

STATE ENGINEER  
Salem, Oregon

YAMH  
5651

# Well Record

STATE WELL NO. 4/4EN-10H  
COUNTY YAMHILL  
APPLICATION NO. GR-2309

OWNER: J. D. Horton


MAILING ADDRESS: Rt 2 Box 193

LOCATION OF WELL: Owner's No. \_\_\_\_\_

CITY AND STATE: McMinnville, Oregon

SE 1/4 NE 1/4 Sec. 10 T. 4 S., R. 4 W., W.M.

Bearing and distance from section or subdivision  
corner 1180' W & 300' N from E corner Section 10

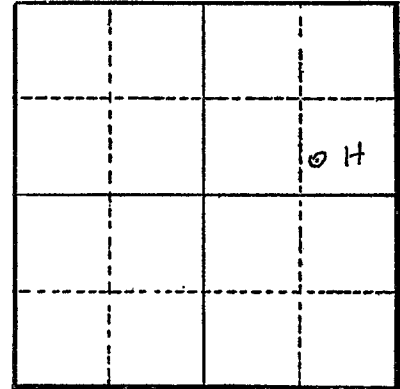

Section 10

Altitude at well \_\_\_\_\_

TYPE OF WELL: Drilled Date Constructed 1950

Depth drilled 83' Depth cased \_\_\_\_\_

### CASING RECORD:

### FINISH:

### AQUIFERS:

### WATER LEVEL:

40'

PUMPING EQUIPMENT: Type Fairbanks Morse Jet H.P. \_\_\_\_\_

Capacity \_\_\_\_\_ G.P.M.

### WELL TESTS:

Drawdown NA ft. after \_\_\_\_\_ hours 30 G.P.M.

Drawdown \_\_\_\_\_ ft. after \_\_\_\_\_ hours \_\_\_\_\_ G.P.M.

USE OF WATER Irrigation Temp. \_\_\_\_\_ °F. \_\_\_\_\_, 19\_\_\_\_\_

SOURCE OF INFORMATION GR-3886

DRILLER or DIGGER Wilcox Drilling Co.

### ADDITIONAL DATA:

Log NA Water Level Measurements \_\_\_\_\_ Chemical Analysis \_\_\_\_\_ Aquifer Test \_\_\_\_\_

### REMARKS: