

STATE ENGINEER
Salem, Oregon

YAMH Well Record
5667


STATE WELL NO. 4/4W-11
COUNTY Yamhill
APPLICATION NO. GR-3912

OWNER: Edward Hoem Jr. MAILING ADDRESS: Rt. 2, Box 141

LOCATION OF WELL: Owner's No. CITY AND STATE: McMinnville

1/4 1/4 Sec. 11 T. 4 N. S., R. 4 E. W., W.M.

Bearing and distance from section or subdivision corner 500' N. & 130' E. from center of Sec. 11

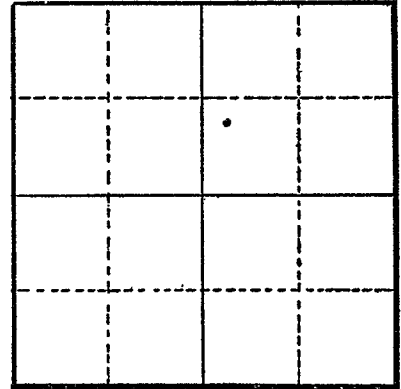

Section 11

Altitude at well

TYPE OF WELL: Drilled Date Constructed 1952

Depth drilled 105 Depth cased 105

CASING RECORD:

8" steel casing 0 to 105 feet

FINISH:

Torch perforations from 90 to 105 feet
8 perforations per foot 12" x 1/4

AQUIFERS:

Unknown

WATER LEVEL:

22 feet

PUMPING EQUIPMENT: Type Berkely turbine H.P. 3
Capacity 60 G.P.M.

WELL TESTS:

Drawdown ft. after hours G.P.M.
Drawdown ft. after hours G.P.M.

USE OF WATER Irrigation Temp. °F., 19

SOURCE OF INFORMATION GR-3912

DRILLER or DIGGER J. L. Wilcox

ADDITIONAL DATA:

Log Water Level Measurements Chemical Analysis Aquifer Test

REMARKS: