

STATE ENGINEER
Salem, Oregon

YAMHILL
5685

Well Record


STATE WELL NO. 4/4W-11K
COUNTY Yamhill
APPLICATION NO. GR-3538

OWNER: William Michael Byerley MAILING ADDRESS: Route 2, Box 144

LOCATION OF WELL: Owner's No. _____ CITY AND STATE: McMinnville, Oregon

NW 1/4 SE 1/4 Sec. 11 T. 4 S., R. 4 W., W.M.

Bearing and distance from section or subdivision corner 1970 feet West and 1540 feet North
from the SE Corner, Section 11

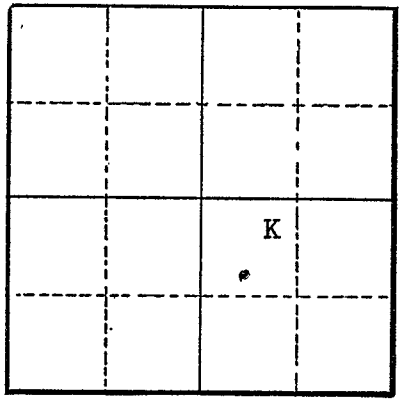

Section 11

Altitude at well _____

TYPE OF WELL: Drilled Date Constructed Apr. 7, '54

Depth drilled 81 feet Depth cased 81 feet

CASING RECORD:

6-inch casing set from 0 to 81 feet

FINISH:

Torch perforations 1/4" x 12 x 6 from 60 to 81 feet

AQUIFERS:

sand, gravel, and clay

WATER LEVEL:

PUMPING EQUIPMENT: Type Berkely Pump - Ejector - 2HP H.P. _____
Capacity 15 gph G.P.M.

WELL TESTS:

Drawdown 60 ft. after _____ hours 30 G.P.M.
Drawdown _____ ft. after _____ hours _____ G.P.M.

USE OF WATER Irrigation Temp. _____ °F. _____, 19____

SOURCE OF INFORMATION GR-4075

DRILLER or DIGGER _____

ADDITIONAL DATA:

Log Water Level Measurements _____ Chemical Analysis _____ Aquifer Test _____

REMARKS:

top soil 0 to 2 blue clay 48 to 55
silty brown clay 2 to 21 compacted sand 55 to 65
brown silt 21 to 35 brown silty clay 65 to 71
silty blue clay 35 to 48 coarse sand with wood and fine gravel 71 to 81

Part of the Henry Bird D.L.C. # 50 in Township 4 South,
Range 4 West of the Willamette Meredian in Yamhill County,
Oregon Described as follows:

4/4w-11-6

Beginning in the center of the county road 22.1 Chains North
and 23.55 Chains North 58° 30' East from the Southwest corner
of said DLC, Thence South 20.35 Chains to the West boundary of
the Southern Pacific R.R., R/W, Thence Northeasterly along the
boundary of said R/W on a 3° curve to the left 1620 feet to the
center of said county road, Thence South 58° 30' West 6.15 Chains
to the place of beginning.