

STATE ENGINEER  
Salem, Oregon

# YAMH Well Record

5723

STATE WELL NO. 4/4W-14N  
COUNTY Yamhill  
APPLICATION NO. GR-2310

OWNER: Robert F. Koester  
MAILING ADDRESS:

LOCATION OF WELL: Owner's No. CITY AND STATE: McMinnville, Oregon


SW 1/4 SW 1/4 Sec. 14 T. 4 S. R. 4 E. W.M.

Bearing and distance from section or subdivision corner 500 feet East and 400 feet North from the SW cor. Sec. 14 8 feet South of iron pipe at NW cor. Lot 34 and NE cor. Lot 35 of Riverside Orchards

Altitude at well 190'

TYPE OF WELL: Drilled Date Constructed July 15, 1948

Depth drilled 114 feet Depth cased 114 feet

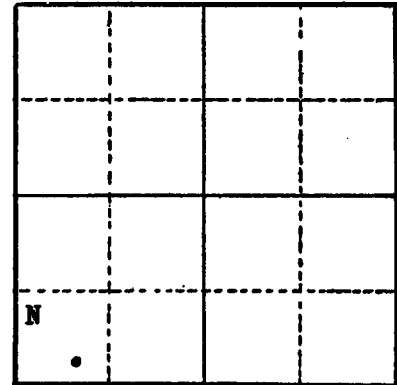

Section 14

### CASING RECORD:

6-inch casing set to 114 feet

### FINISH:

80 perforations set from 94 to 114 feet

### AQUIFERS:

sand and gravels

### WATER LEVEL:

18 feet

PUMPING EQUIPMENT: Type Fairbanks Morse (Little Chief) H.P. 3  
Capacity 35 G.P.M.

### WELL TESTS:

Drawdown 70 ft. after 35 hours G.P.M.  
Drawdown ft. after hours G.P.M.

USE OF WATER Irrigation Temp. °F., 19

SOURCE OF INFORMATION GR-4007

DRILLER or DIGGER Wilcox Drilling Co.

### ADDITIONAL DATA:

Log  Water Level Measurements Chemical Analysis Aquifer Test

### REMARKS:

