


YAMH
5725

OWNER: Arthur Ptacek MAILING ADDRESS: Route 1, Box 24

LOCATION OF WELL: Owner's No. _____ CITY AND STATE: McMinnville, Oregon

SW $\frac{1}{4}$ SW $\frac{1}{4}$ Sec. 14 T. 4 N. S., R. 4 E. W., W.M.

Bearing and distance from section or subdivision corner 950 feet N. & 900 feet E.

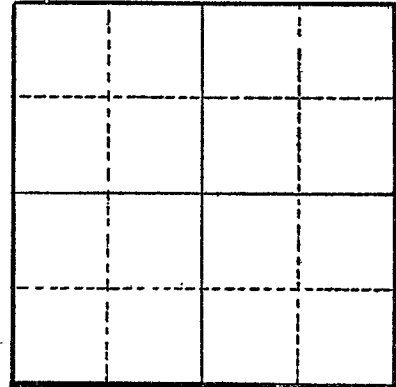

Section _____

Altitude at well _____

TYPE OF WELL: Drilled Date Constructed 1951

Depth drilled 95 feet Depth cased 95 feet

CASING RECORD:

8-inch

FINISH:

Torch perforations 12" x $\frac{1}{4}$ ", 8 per foot, from 80 to 95

AQUIFERS:

Top soil, clay, sand, and gravel

WATER LEVEL:

20 feet

PUMPING EQUIPMENT: Type Little Chief F & M turbine H.P. 3
Capacity 50 G.P.M.

WELL TESTS:

Drawdown 55 ft. after _____ hours Pumping 30 G.P.M.
Drawdown _____ ft. after _____ hours _____ G.P.M.

USE OF WATER Irrigation Temp. _____ °F. _____, 19

SOURCE OF INFORMATION GR-2901

DRILLER or DIGGER J. L. Wilcox, P. O. Box 569, McMinnville, Oregon

ADDITIONAL DATA:

Log Water Level Measurements _____ Chemical Analysis _____, _____ Aquifer Test _____

REMARKS:	Top soil	0	2
	Clay	2	19
	Silty gray clay	19	47
	Compacted fine sand	47	66
	Blue clay	66	81
	Sand and fine gravel	81	93
	Clay	93	95

A 12" was used to 95' the casing is gravel packed to 20' below the surface and a seal put in to 20' using cement grout next to the gravel and puddled clay poured in on the grout after it had set.