

STATE ENGINEER
Salem, Oregon

YAMH
5766

Well Record

GR- 1750

STATE WELL NO. 4/4W-20M
COUNTY Yamhill
APPLICATION NO. GR- 1809

OWNER: Lloyd W. Oddy


MAILING ADDRESS: 518 S. Cowls St.

LOCATION OF WELL: Owner's No.

CITY AND STATE: McMinnville, Oregon

NW 1/4 SW 1/4 Sec. 20 T. 4 S., R. 4 W., W.M.

Bearing and distance from section or subdivision corner 300' E. & 410' S. from W¹/₄ cor. Sec. 20

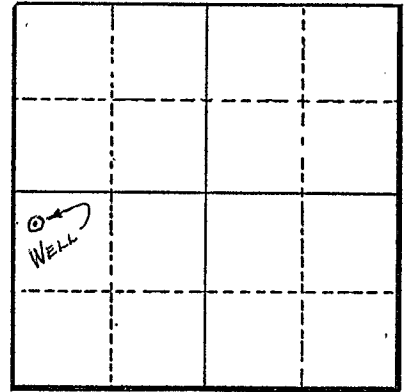

Section 20

Altitude at well 157'

TYPE OF WELL: Dug & Drilled Date Constructed 1928

Depth drilled 66' Depth cased 66'

CASING RECORD:

6" steel casing from 0 to 66 ft.
5' brick casing from 0 to 33 ft.

FINISH:

Perforated

AQUIFERS:

WATER LEVEL:

4'

PUMPING EQUIPMENT: Type F. M. H.P. 3
Capacity 40 G.P.M.

WELL TESTS:

Drawdown 6 ft. after 35 hours G.P.M.
Drawdown ft. after hours G.P.M.

USE OF WATER Irrigation Temp. °F. 19

SOURCE OF INFORMATION GR Record

DRILLER or DIGGER

ADDITIONAL DATA:

Log N.A. Water Level Measurements Chemical Analysis Aquifer Test

REMARKS:

Irrigation of 7.77 acres.