

STATE ENGINEER  
Salem, Oregon

**YAMHILL**  
**5847**

# Well Record

STATE WELL NO. 4/4W-24J(1)  
COUNTY Yamhill  
APPLICATION NO. GR-127

OWNER: Mary Lee & Ross Cruickshank

MAILING ADDRESS:

Rt. 2, Box 120


LOCATION OF WELL: Owner's No. #2

CITY AND STATE:

Dayton, Oregon

SE 1/4 SE 1/4 Sec. 24 T. 4 S., R. 4 W., W.M.

Bearing and distance from section or subdivision corner 1320 feet north and 210 feet west from SE corner of Section 24

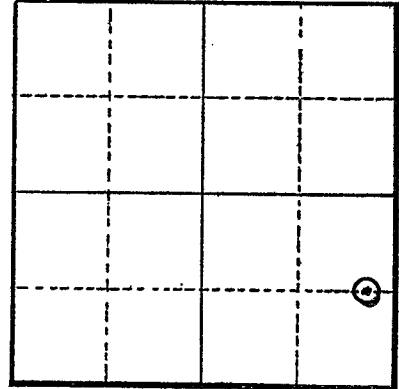

Section 24

Altitude at well 155 feet Interpolated

TYPE OF WELL: Drilled Date Constructed Nov. '51

Depth drilled 114 Depth cased 114

### CASING RECORD:

8 inch casing set from 0 to 114 feet

### FINISH:

Perforations 12" x 1/8" from 94 to 114 feet

### AQUIFERS:

unknown

### WATER LEVEL:

10 feet below land surface - summer  
40 to 50 feet below land surface - winter

PUMPING EQUIPMENT: Type Lane Boller Turbine H.P. 7 1/2  
Capacity 100 G.P.M.

### WELL TESTS:

Drawdown 75 ft. after 100 hours        G.P.M.  
Drawdown        ft. after        hours        G.P.M.

USE OF WATER Irrigation 87.1 acres Temp.        °F. 19

SOURCE OF INFORMATION Registration Statement GR-127

DRILLER or DIGGER Wilcox Drilling Company, McMinnville, Oregon

### ADDITIONAL DATA:

Log No Water Level Measurements        Chemical Analysis        Aquifer Test       

### REMARKS: