

STATE ENGINEER  
Salem, Oregon

*YAMHILL*  
*5854*

# Well Record

STATE WELL NO. 4/4W-25A(1)  
COUNTY Yamhill  
APPLICATION NO. GR-127

OWNER: Ross and Mary Lee Cruickshank

MAILING ADDRESS:


Rt. 2, Box 120

LOCATION OF WELL: Owner's No. 1

CITY AND STATE:

NE 1/4 NE 1/4 Sec. 25 T. 4 N. S., R. 4 E. W., W.M.

Bearing and distance from section or subdivision corner 360 feet south and 180 feet west of Section corner (or NE 1/4 Sec. 25)

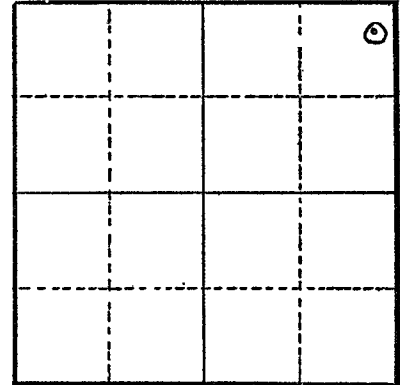

Section 25

Altitude at well 155 feet Interpolated

TYPE OF WELL: Drilled Date Constructed Nov. '46

Depth drilled 68 Depth cased 68

### CASING RECORD:

6 inch casing set from 0 to 68 feet

### FINISH:

Cut slots 12" x 1/8" from 48 to 68 feet.

### AQUIFERS:

Unknown

### WATER LEVEL:

5-10 feet - winter

15-20 feet - summer 12/1946

PUMPING EQUIPMENT: Type Pacific Jet

H.P. 3

Capacity 50 G.P.M.

### WELL TESTS:

Drawdown 30 ft. after \_\_\_\_\_ hours 50 G.P.M.

Drawdown \_\_\_\_\_ ft. after \_\_\_\_\_ hours \_\_\_\_\_ G.P.M.

USE OF WATER Irrigation 87.1 acres Temp. \_\_\_\_\_ °F., 19 \_\_\_\_\_

SOURCE OF INFORMATION Registration Statement GR-127

DRILLER or DIGGER Wilcox Drilling Co., McMinnville, Oregon

### ADDITIONAL DATA:

Log NO Water Level Measurements \_\_\_\_\_ Chemical Analysis \_\_\_\_\_ Aquifer Test \_\_\_\_\_

### REMARKS:

Irrigated land located to the north in Sections 19 and 24.