
| | | | | • [| Page 1 of 3 |
|--|--|---------------------------------|--|-----------------------|---------------------|
| STATE OF OREGON | YAMH | 59459 | WELL I.D. LABEL# | | |
| WATER SUPPLY WELL REPORT | | | START CARD # | 1073049 | |
| (as required by ORS 537.545 & 537.765 and OAR 690-205-0210) | 5/23/ | 2024 | ORIGINAL LOG # | | |
| (1) LAND OWNER Owner Well I.D. | | | | | |
| First Name TIM Last Name KREDER | | (9) LOCAT | ION OF WELL (legal o | description) | |
| Company PALMER CREEK FARMS LLC Address 11700 SE AMITY DAYTON HWY | | | LL Twp <u>4.00</u> S N | | W E/W WM |
| City DAYTON State OR Zip 97114 | | Sec <u>31</u> | SW 1/4 of the <u>NE</u> | 1/4 Tax Lot <u>10</u> | |
| | ersion | Tax Map Numb | er or <u>45.1797256</u> | Lot | |
| Alteration (complete 2a & 10) Abandonment(co | mplete 5a) | Lat° | " or <u>45.1797256</u> | 3 | DMS or DD |
| (2a) PRE-ALTERATION | <u>inpiete eta)</u> | | " or <u>-123.10275</u> | 053 | DMS or DD |
| Dia + From To Gauge Stl Plstc Wld Thrd | | \sim | \sim | earest address | |
| | | 10500 LAFAY | ETTE HWY, DAYTON OR | | |
| Material From To Amt sacks/lbs | | | | | |
| (3) DRILL METHOD | | (10) STATI | C WATER LEVEL | | |
| X Rotary Air Rotary Mud Cable Auger Cable Mud | | | Date | e SWL(psi) + | SWL(ft) |
| Reverse Rotary X Other CASING ADVANCE | | | ell / Pre-Alteration | | |
| | | Completed | Well 5/17/2024 Flowing Artesian? | | 27 |
| (4) PROPOSED USE Domestic X Irrigation Community | | | - | Dry Hole? | |
| Industrial/ Commercial Livestock Dewatering | | WATER BEARI | | rater was first found | |
| ThermalOther | | SWL Date | From To Es | t Flow SWL(psi) | + SWL(ft) |
| (5) BORE HOLE CONSTRUCTION Special Standard (A | Attach copy) | 5/17/2024 | 94 232 | 600 | 27 |
| Depth of Completed Well 232.00 ft. | | | | | |
| BORE HOLE SEAL | sacks/ | | | | |
| | ant lbs | | | | |
| | 32 S 31 | | | | |
| | 32 S | | | | |
| | 16 | (11) WELL 1 | LOG Ground Elevation | on | |
| Seal placement method A B C D E Other: POUR AND F | PROBE BENT | | Material | From | То |
| Backfill placed from <u>50</u> ft. to <u>86</u> ft. Material <u>SLOUGH A</u> | | Clay, brown | | 0 | 5 |
| Filter pack from <u>122</u> ft. to <u>232</u> ft. Material SIL Size § | 8/12 | Clay, brown, sti | icky | 5 | 16 |
| Explosives used: Type Amount | | Clay, grey, | · · 1 · C | 16 | 70 |
| | 00 | | with sand, fine th some gravel, pea | 94 | 94 |
| (5a) ABANDONMENT USING UNHYDRATED BENTONI | TE | | e, with some clay, silty | 144 | 144 |
| Proposed Amount Actual Amount | | Sand, dark grey | | 145 | 154 |
| 1 | | | , fine, with some wood | 154 | 163 |
| (6) CASING/LINER Casing Liner Dia + From To Gauge Stl Plstc V | Wld Thrd | Sand black, coa | | 163 | 174 |
| | | | some sand, black coarse | 174 | 182 |
| | | Clay, green, me | | 182 | 188 |
| $\bigcirc \bigcirc \bigcirc 8 \qquad 187 \qquad 197 \qquad .250 \qquad \bigcirc \bigcirc \bigcirc$ | \mathbf{X} | Gravel, pea, wit Gravel, Pea | III some clay | 100 | 201 |
| | 50 Gravel, pea, with sand, brown, coarse | | | 201 | 224 |
| | | Sand, brown, co | | 224 | 232 |
| Shoe Inside Outside Other Location of shoe(s) 23 | 2 | | | | |
| Temp casing X Yes Dia 16 From $+ [X]$ 1 To 88 | | | | | |
| (7) PERFORATIONS/SCREENS | | | | | |
| Perforations Method | | Construction | | | 11 |
| Screens Type V-Shaped Wire Rope Material 304SS | T-1-/ | Begin Date 3/2 | 28/2024 Begin Time 09 | 00 End Da | te <u>5/17/2024</u> |
| Perf/ Casing/ Screen Scrn/slot Slot # of Screen Liner Dia From To width length slots | Tele/ pipe size | (unbonded) W | ater Well Constructor Certif | ication | |
| Screen Liner 8 127 187 40 | 8 | I certify that th | ne work I performed on the co | onstruction, deepen | ing, alteration, or |
| Screen Liner 8 197 227 40 | 8 | | of this well is in compliance | | |
| | | | andards. Materials used and ir | iformation reported | above are true to |
| | | • | knowledge and belief. | N =4- | |
| | | License Numbe | er <u>2017</u> D | Date <u>5/23/2024</u> | |
| (8) WELL TESTS: Minimum testing time is 1 hour | | Signed COE | I REED (E-filed) | | |
| Pump | rtesian | | | | |
| Yield gal/min Drawdown Drill stem/Pump depth Duration (h | nr) | , , | r Well Constructor Certificat | | |
| 320 83 115 4 | | | sibility for the construction, d | | |
| | | | l on this well during the constru- ng this time is in compliand | | |
| Temperature 55 °F Lab analysis Yes By | 1 | | ndards. This report is true to the | | |
| | ppm | | - | Date 5/23/2024 | - |
| Water quality concerns? Yes (describe below) TDS amount 182 From To Description Amount | Units | | - <u>1900</u> D | | |
| | | Signed ERIC | SCHNEIDER (E-filed) | | |
| | | | otional) | | |
| | | | | | |

ORIGINAL - WATER RESOURCES DEPARTMENT THIS REPORT MUST BE SUBMITTED TO THE WATER RESOURCES DEPARTMENT WITHIN 30 DAYS OF COMPLETION OF WORK Form Version: New exempt use wells must be submitted with a map and recording fee.

WATER SUPPLY WELL REPORT -

continuation page

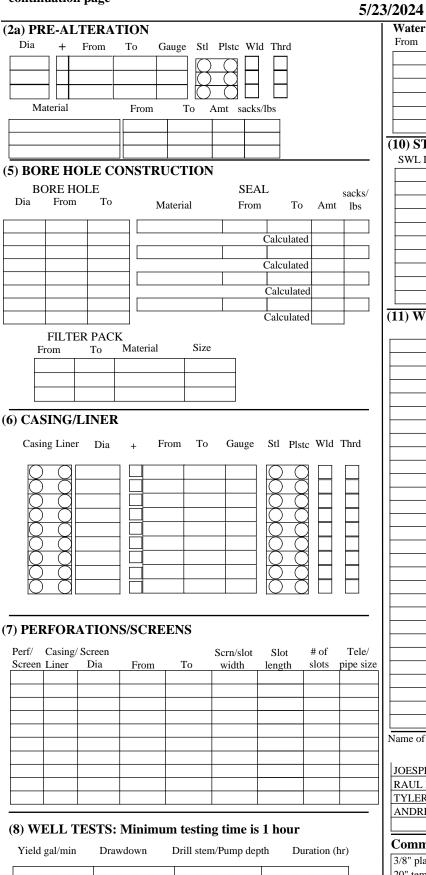

WELL I.D. LABEL# L 143592 START CARD # 1073049

ORIGINAL LOG

YAMH 59459

| water Quality Concerns | | | | | | |
|------------------------|----|-------------|--------|-------|--|--|
| From | То | Description | Amount | Units | | |
| | | | | | | |
| | | | | | | |
| | | | | | | |
| | | | | | | |
| | | | | | | |
| | | | | | | |

(10) STATIC WATER LEVEL

| SWL Date | From | То | Est Flow | SWL(psi) | + | SWL(ft) |
|----------|------|----|----------|----------|---|---------|
| | | | | | | |
| | | | | | | |
(11) WELL LOG

| Material | From | То |
|---------------------------------------|--------------------------------|------------------|
| | | |
| | | |
| | | _ |
| | | _ |
| | | - |
| | | - |
| | | |
| | | _ |
| | | _ |
| | | _ |
| | | _ |
| | | _ |
| | | _ |
| | | _ |
| | | _ |
| | | |
| | | |
| | | |
| | | |
| | | |
| | | |
| | | |
| | | _ |
| | | - |
| | | |
| | | _ |
| | | _ |
| | | _ |
| | | _ |
| | | _ |
| | | |
| Name of person(s) who assisted with c | construction and Trainee Licer | nse # / Helper # |
| Assistant Name | Туре | # |

| Assistant Name | Type | # |
|---------------------|--------------|---------|
| JOESPH ALAGOZ | HELPER WATER | 8888910 |
| RAUL DAZA CERVANTES | HELPER WATER | 8888911 |
| TYLER JESKE | HELPER WATER | 8888953 |
| ANDREW PETRIE | HELPER WATER | 8888908 |
| | | |

Comments/Remarks

3/8" plate welded to bottom of screen

20" temporary casing used to 14', 16" temporary casing used to 86'.

WATER SUPPLY WELL REPORT - Map with location identified must be attached and shall include an approximate scale and north arrow **YAMH 59459**

5/23/2024

Map of Hole

STATE OF OREGON WELL LOCATION MAP

This map is supplemental to the WATER SUPPLY WELL REPORT

LOCATION OF WELL

Latitude: 45.17972563 Datum: WGS84 Longitude: -123.10275053 Township/Range/Section/Quarter-Quarter Section: WM4.00S3.00W31SWNE Address of Well: 10500 LAFAYETTE HWY, DAYTON OR

Oregon Water Resources Department 725 Summer St NE, Salem OR 97301 (503)986-0900



Well Label: 143592

Printed: May 23, 2024

DISCLAIMER: This map is intended to represent the approximate location the well. It is not intended to be construed as survey accurate in any manner.

Provided by well constructor

