

STATE ENGINEER  
Salem, Oregon

**YAMHILL**  
**5954**

# Well Record


STATE WELL NO. 4/4W-36A  
COUNTY Yamhill  
APPLICATION NO. GR-886

OWNER: Donald C. Goodrich MAILING ADDRESS: Dayton

LOCATION OF WELL: Owner's No. \_\_\_\_\_ CITY AND STATE: \_\_\_\_\_

NE 1/4 NE 1/4 Sec. 36 T. 4 <sup>N.</sup> S., R. 4 <sup>E.</sup> W., W.M.

Bearing and distance from section or subdivision corner 930 feet west and 900 feet south  
from NE corner, Section 36

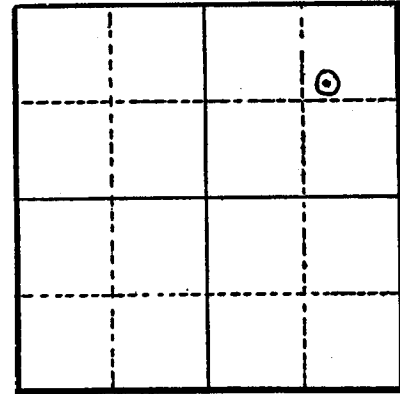

Altitude at well 145

TYPE OF WELL: Drilled Date Constructed Nov. '52

Depth drilled 131 Depth cased \_\_\_\_\_

Section \_\_\_\_\_

### CASING RECORD:

FINISH:

AQUIFERS:

WATER LEVEL:

Varies

PUMPING EQUIPMENT: Type Fairbanks Morse Pomona Turbine H.P. 15 Elec.  
Capacity 200 G.P.M.

WELL TESTS:  
Drawdown 29 ft. after \_\_\_\_\_ hours 380 G.P.M.  
Drawdown \_\_\_\_\_ ft. after \_\_\_\_\_ hours \_\_\_\_\_ G.P.M.

USE OF WATER Irrigation Temp. \_\_\_\_\_ °F., 19.

SOURCE OF INFORMATION Owner  
DRILLER or DIGGER Wilcox Drilling Co. McMinnville, Oregon

ADDITIONAL DATA:  
Log NA Water Level Measurements \_\_\_\_\_ Chemical Analysis \_\_\_\_\_ Aquifer Test \_\_\_\_\_

REMARKS: