

STATE ENGINEER  
Salem, Oregon

**YAMHILL**  
**5962**

# Well Record

STATE WELL NO. 4/AW-36G(1)  
COUNTY Yamhill  
APPLICATION NO. GR-980

GR- 950

OWNER: Arthur Leppin Sr.


MAILING ADDRESS: Rt. 1, Box 240

LOCATION OF WELL: Owner's No. \_\_\_\_\_

CITY AND STATE: Rickreall, Oregon

SW 1/4 NE 1/4 Sec. 36 T. 4 S., R. 4 W., W.M.

Bearing and distance from section or subdivision corner Approx. 1750' S. & 1355' W. of the NE cor. of Sec. 36.

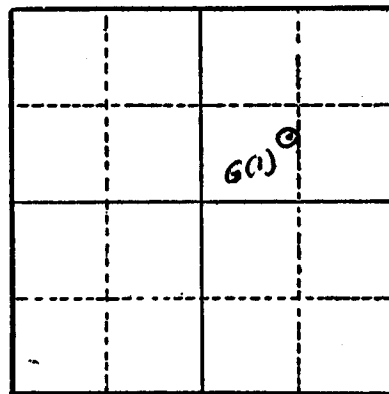

Section 36

Altitude at well 151 ft.

TYPE OF WELL: Drilled Date Constructed 1952

Depth drilled 126 ft. Depth cased 126 ft.

### CASING RECORD:

8 inch

### FINISH:

1/4" x 6" perforations from 89 to 126 ft.

### AQUIFERS:

### WATER LEVEL:

89 ft.

PUMPING EQUIPMENT: Type Fairbanks Morse Turbine H.P. 20  
Capacity 350 G.P.M.

### WELL TESTS:

Drawdown 69 ft. after \_\_\_\_\_ hours 390 G.P.M.  
Drawdown \_\_\_\_\_ ft. after \_\_\_\_\_ hours \_\_\_\_\_ G.P.M.

USE OF WATER Irrigation Temp. \_\_\_\_\_ °F. \_\_\_\_\_, 19\_\_\_\_

SOURCE OF INFORMATION G.R. Record

DRILLER or DIGGER \_\_\_\_\_

### ADDITIONAL DATA:

Log \_\_\_\_\_ Water Level Measurements \_\_\_\_\_ Chemical Analysis \_\_\_\_\_ Aquifer Test \_\_\_\_\_

### REMARKS:

- Log: Top soil 0 to 2 ft.
- Brown clay 2 to 15 ft.
- Silty blue clay 15 to 24 ft.
- Blue clay 24 to 47 ft.
- Compact fine sand 47 to 76 ft.
- Tuff blue clay 76 to 89 ft.
- Black sand & fine gravel 89 to 94 ft.
- Brown sand & clay with gravel 94 to 113 ft.
- Gravel \_\_\_\_\_

Irrigation of 96 acres