

STATE ENGINEER
Salem, Oregon

YAMHILL
5964


Well Record

STATE WELL NO. 4/4W-36G
COUNTY Yamhill
APPLICATION NO. GR-950

OWNER: Benjamin & Mable Eiselstein MAILING ADDRESS: Rt. 2, Box 108
CITY AND STATE: Dayton

LOCATION OF WELL: Owner's No. _____
SW 1/4 SE 1/4 Sec. 36 T. 4 N. S., R. 4 E. W., W.M.

Bearing and distance from section or subdivision corner N 58° W. 500' from IP (C.S. 3238) which I. P. is S. 89° 27' W. 785.4' & N. 20° 34' E. 1102.8 & N. 20° 55' E. 582.1' from SE cor.
William Goodrich DLC
Altitude at well 155

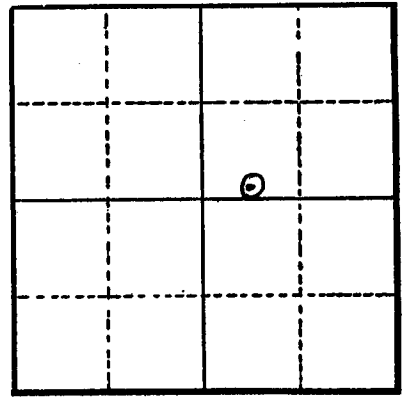

Section 36

TYPE OF WELL: Drilled Date Constructed March '53
Depth drilled 123 Depth cased 123

CASING RECORD:

8-inch diameter 0 to 123

FINISH:

Well perforated for 40' at bottom 83' - 123'

AQUIFERS:

WATER LEVEL:

PUMPING EQUIPMENT: Type Jacuzzi Turbine H.P. 5 Elec
Capacity 125 G.P.M. 3 phase

WELL TESTS:
Drawdown 60 ft. after _____ hours 250 G.P.M.
Drawdown _____ ft. after _____ hours _____ G.P.M.

USE OF WATER Irrigation Temp. _____ °F. _____, 19_____
SOURCE OF INFORMATION Owner
DRILLER or DIGGER Wilcox Drilling
ADDITIONAL DATA:
Log NA Water Level Measurements _____ Chemical Analysis _____ Aquifer Test _____

REMARKS: