

STATE ENGINEER
Salem, Oregon

YAMH Well Record
6214

STATE WELL NO. 4/5W-25F
COUNTY YAMHILL
APPLICATION NO. GR-1920

OWNER: W. W. Redmond


MAILING
ADDRESS: Rt 3, Box 311

LOCATION OF WELL: Owner's No. _____

CITY AND
STATE: McMinnville, Oregon

SE $\frac{1}{4}$ NW $\frac{1}{4}$ Sec. 25 T. 4 S., R. _____ W., W.M.

Bearing and distance from section or subdivision
corner 170' N & 990' W from center of Section 25

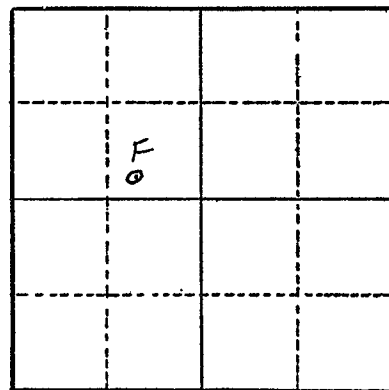

Section 25

Altitude at well _____

TYPE OF WELL: drilled Date Constructed 1953

Depth drilled 165' Depth cased 60'

CASING RECORD:

6-inch

FINISH:

AQUIFERS: Loam and Clay
Solid rock
Gravel

WATER LEVEL: 150'

PUMPING EQUIPMENT: Type Jet H.P. 3
Capacity 35 G.P.M.

WELL TESTS:
Drawdown 30 ft. after _____ hours 35 G.P.M.
Drawdown _____ ft. after _____ hours _____ G.P.M.

USE OF WATER Irrigation Temp. _____ °F. _____, 19____

SOURCE OF INFORMATION GR-3880

DRILLER or DIGGER Hoffman Drilling Co.

ADDITIONAL DATA:

Log x Water Level Measurements _____ Chemical Analysis _____ Aquifer Test _____

REMARKS:

Loam and Clay 20'
solid rock 140'
Gravel 5'