

STATE ENGINEER
Salem, Oregon

YAMHILL Well Record
6360 GR-1747

STATE WELL NO. 5/3W-2B
COUNTY Yamhill
APPLICATION NO. GR-1806

OWNER: Glen A. McFarlane


MAILING ADDRESS:

LOCATION OF WELL: Owner's No.

CITY AND STATE: Dayton, Oregon

NW 1/4 NE 1/4 Sec. 2 T. 5 S., R. 3 W., W.M.

Bearing and distance from section or subdivision corner 1575' W. & 400' S. from NE Cor. Sec. 2

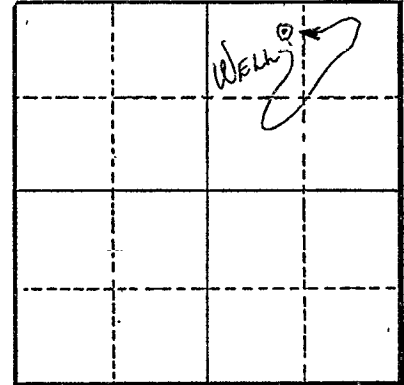

Section 2

Altitude at well

TYPE OF WELL: Drilled. Date Constructed 1940

Depth drilled 28' Depth cased

CASING RECORD:
12"

FINISH:
Perforated

AQUIFERS:

WATER LEVEL:
4'

PUMPING EQUIPMENT: Type F. M. H.P. 40
Capacity 1000 G.P.M.

WELL TESTS:
Drawdown 12 ft. after 1000 hours G.P.M.
Drawdown ft. after hours G.P.M.

USE OF WATER Irrigation Temp. °F., 19

SOURCE OF INFORMATION GR Record

DRILLER or DIGGER Hauffman

ADDITIONAL DATA:
Log N.A. Water Level Measurements Chemical Analysis Aquifer Test

REMARKS:
Irrigation of 123.0 acres.