

STATE ENGINEER
Salem, Oregon

YAMH
6363

Well Record

STATE WELL NO. 5/3W - 3N
COUNTY YAMHILL
APPLICATION NO. GR-2034

OWNER: U. S. Alderman


MAILING ADDRESS:

LOCATION OF WELL: Owner's No. #6

CITY AND STATE: Dayton, Oregon

SW 1/4 SW 1/4 Sec. 3 T. 5 S. R. 3 W., W.M.

Bearing and distance from section or subdivision corner 730' N. 5° 12' E.

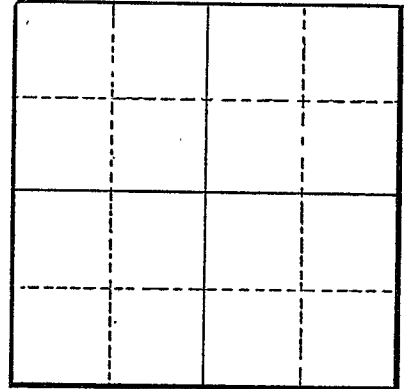

Section

Altitude at well

TYPE OF WELL: Drilled Date Constructed 1944

Depth drilled 33 Depth cased 33

CASING RECORD:

10-inch

FINISH:

Perforations from 23 to 33

AQUIFERS:

Sand, gravel, clay and soil

WATER LEVEL:

6-feet

PUMPING EQUIPMENT: Type Fairbanks Morse 3" Centrifugal H.P. 90
Capacity 420 G.P.M.

WELL TESTS:

Drawdown	ft. after	hours	G.P.M.
Drawdown	ft. after	hours	G.P.M.

USE OF WATER Irrigation Temp. °F., 19....

SOURCE OF INFORMATION GR-1960

DRILLER or DIGGER Fred Wymore, Willamette Drilling Co., Rt. 2, Salem, Oregon

ADDITIONAL DATA:

Log Water Level Measurements Chemical Analysis Aquifer Test

REMARKS:

Top soil	2	2
Yellow clay	16	18
Water bearing sand	5	23
Water bearing gravel	10	33