

STATE ENGINEER
Salem, Oregon

YAMH
6384 Well Record

STATE WELL NO. 5/34-5 (1)
COUNTY Yamhill
APPLICATION NO. 6-22

OWNER: Joseph V. Springer

MAILING
ADDRESS:


LOCATION OF WELL: Owner's No.

CITY AND
STATE:

Portland, Ore

NW 1/4 NW 1/4 Sec. 5 T. 5 S. R. 3 W., W.M.

Bearing and distance from section or subdivision
corner

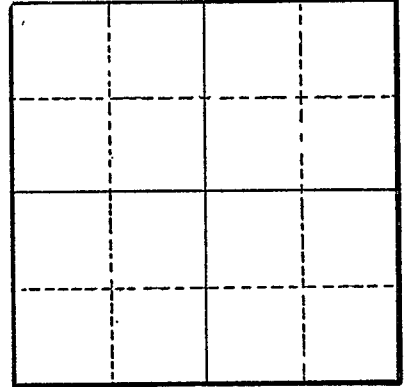

Altitude at well 150

TYPE OF WELL: Drilled Date Constructed March 1954

Depth drilled 212 Depth cased

Section

CASING RECORD:

17 inch 0 - 200 ft. (?) Gr. cert. book
8 inch 38.6 - 80 ✓
6 inch 131 - 205 ✓

FINISH:

AQUIFERS:

WATER LEVEL:

26

PUMPING EQUIPMENT: Type Font Johnston turbine H.P. 25
Capacity G.P.M.

WELL TESTS:

Drawdown ft. after hours G.P.M.
Drawdown ft. after hours G.P.M.

USE OF WATER irrigation Temp. °F., 19

SOURCE OF INFORMATION

DRILLER or DIGGER

ADDITIONAL DATA:

Log X Water Level Measurements Chemical Analysis Aquifer Test

REMARKS:

