

STATE ENGINEER  
Salem, Oregon

*YAMH  
6393*

# Well Record

GR- 1331


STATE WELL NO. 5/3W-60  
COUNTY Yamhill  
APPLICATION NO. GR- 1373

OWNER: Edward F. & Wilmetta Schroeder MAILING ADDRESS: Rt. 1, Box 29

LOCATION OF WELL: Owner's No. \_\_\_\_\_ CITY AND STATE: Dayton, Oregon

NE  $\frac{1}{4}$  NW  $\frac{1}{4}$  Sec. 6 T. 5 N. S., R. 3 EX W., W.M.

Bearing and distance from section or subdivision corner 450' S. & 2500' E. from NW cor. Sec. 6

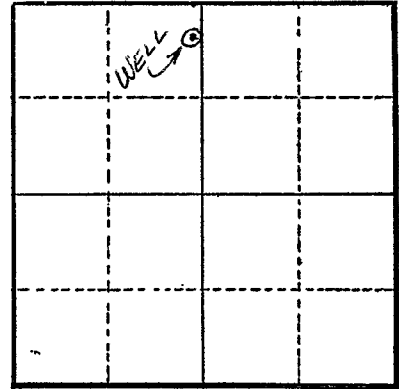

Section 6

Altitude at well 155 ft.

TYPE OF WELL: Drilled Date Constructed 1947

Depth drilled 80 ft. Depth cased 80 ft.

### CASING RECORD:

6 in.

### FINISH:

Perforated:  $\frac{1}{4}$  x 12 in. cuts from 60 to 80 ft.

### AQUIFERS:

Black sand from 60 to 80 ft.

### WATER LEVEL:

At surface

PUMPING EQUIPMENT: Type Pomona turbine H.P. 5

Capacity 80 G.P.M.

### WELL TESTS:

Drawdown 50 ft. after \_\_\_\_\_ hours 80 G.P.M.

Drawdown \_\_\_\_\_ ft. after \_\_\_\_\_ hours \_\_\_\_\_ G.P.M.

USE OF WATER Irrigation Temp. \_\_\_\_\_ °F. \_\_\_\_\_, 19\_\_\_\_

SOURCE OF INFORMATION G. R. Record

DRILLER or DIGGER J. L. Wilcox

### ADDITIONAL DATA:

Log N.A. Water Level Measurements \_\_\_\_\_ Chemical Analysis \_\_\_\_\_ Aquifer Test \_\_\_\_\_

### REMARKS:

Irrigation of 27 acres.